

TATE
2037 G
5-26-78

**MISSISSIPPI  
BOARD OF WATER COMMISSIONERS**  
416 North State Street  
Jackson, Mississippi 39201

**WATER WELL DRILLERS LOG**

5-26 1978 Hick Wells Co Tate  
 date well completed firm name county well located

LANDOWNER: Sidney Wooten  
Rt. 2  
Caldwater, Mo.  
 (mailing address)

description of formations encountered	from	to
Red clay	0	15
Red sand	15	115
White sand	115	168

WELL LOCATION:  
 sec. 9 T 5 N R 7 E  
2 1/2 miles SE of Caldwater  
 (distance) (direction) (nearest town)

WELL PURPOSE: Home  
 (home, irrigation, municipal, industrial)

WELL COMPLETION DATA:

(1) diameter (inches) 4

(2) total depth (feet) ~~168~~ 168

(3) static water level (feet) 148 below top of ground.

(4) casing PVC, 168,  
 (material) (depth)

\_\_\_\_\_ If telescope see back.  
 (size)

(5) screen 7, 161  
 (length) (depth to top)

4, gravel type  
 (size) (material)

(6) pump 1/2 10  
 (HP) (yield gpm)

220V  
 (type power)

(7) electric log No  
 (yes or no)

\_\_\_\_\_ (organization running log)

(8) how well bottom plugged Cap

DRILLERS REMARKS:  
 \_\_\_\_\_  
 \_\_\_\_\_


**RECEIVED**

JUN 29 1978

MISS. BOARD OF WATER COMMISSIONERS

If well telescopes please sketch and show depths.

GROUND LEVEL

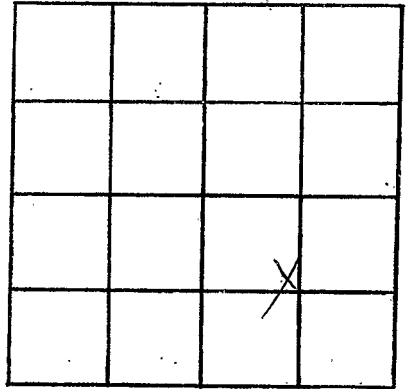

SECTION 9

Please indicate well location X.

ADDITIONAL INFORMATION

If more than one screen,  
show locations of each on sketch.