

TATE  
 G 2038  
 5-30-78

MISSISSIPPI  
 BOARD OF WATER COMMISSIONERS  
 416 North State Street  
 Jackson, Mississippi 39201

WATER WELL DRILLERS LOG

5-30-78 date well completed      Hick Wells Co firm name      Tate county well located


LANDOWNER: Cleveland Ballard  
P.O. Box 6-D  
Collierville, Mo.  
 (mailing address)

description of formations encountered	from	to
Red clay	0	15
Red sand	15	98
white sand	98	127

WELL LOCATION:  
 sec. 15 T. 5 N. R. 7 E.  
3 miles NE of Senatobia  
 (distance) (direction) (nearest town)

WELL PURPOSE: Home  
 (home, irrigation, municipal, industrial)

- WELL COMPLETION DATA:
- (1) diameter (inches) 4
  - (2) total depth (feet) 127
  - (3) static water level (feet) 100 below top of ground.
  - (4) casing PVC, 127.  
 (material) (depth)  
 \_\_\_\_\_ if telescope see back.  
 (size)
  - (5) screen 7, 120  
 (length) (depth to top)  
4 (size), perforated type (material)
  - (6) pump 1/2 10  
 (HP) (yield gpm)  
2200  
 (type power)
  - (7) electric log No  
 (yes or no)
  - \_\_\_\_\_ (organization running log)
  - (8) how well bottom plugged Cg

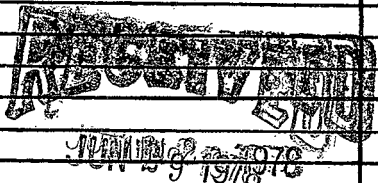


DRILLERS REMARKS:

MISS. DEPT. OF WATER CONTROL

If well telescopes please sketch and show depths.

GROUND LEVEL

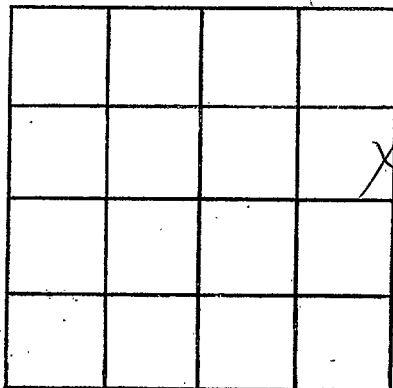

SECTION 15

Please indicate well location X.

ADDITIONAL INFORMATION

If more than one screen,  
show locations of each on sketch.