

Big Stream Well Drilling
Co.

MISSISSIPPI
BOARD OF WATER COMMISSIONERS
416 North State Street
Jackson, Mississippi 39201

WATER WELL DRILLERS LOG

TATE
G 2057

7-13-78 19 G.B. Cain Tate
date well completed firm name county well located

LANDOWNER: N.M.G. College
Sanatobia Miss
(mailing address)

description of formations encountered	from	to
Clay	0	14
Sand	14	65

WELL LOCATION:
sec. 18 T 5 N R 7 E
S W
1 1/2 miles N.W. of Sanatobia
(distance) (direction) (nearest town)

WELL PURPOSE: Farm
(home, irrigation, municipal, industrial)


- WELL COMPLETION DATA:
- (1) diameter (inches) 4
 - (2) total depth (feet) 65
 - (3) static water level (feet) 15 ^(below) _{above} top of ground
 - (4) casing Plast. 65
(material) (depth)
 - (size) If telescope see back.
 - (5) screen 10 55
(length) (depth to top)
 - 4 Plast
(size) (material)
 - (6) pump 1 15
(HP) (yield gpm)
 - Elect
(type power)
 - (7) electric log (yes or no)
 - (organization running log)
 - (8) how well bottom plugged Plug

DRILLERS REMARKS:

RECEIVED
JUL 26 1978
MISS. BD. OF WATER COMM

If well telescopes please
sketch and show depths.

GROUND LEVEL

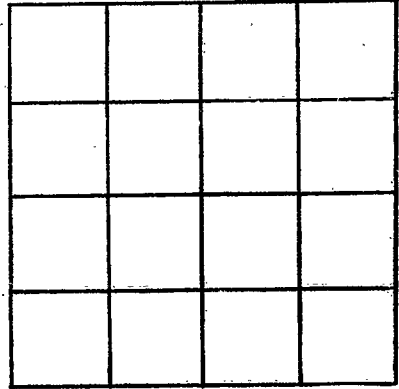

SECTION _____

Please indicate well location X.

ADDITIONAL INFORMATION

If more than one screen,
show locations of each on sketch.