

TATE
G 2040
9-7-78

MISSISSIPPI
 BOARD OF WATER COMMISSIONERS
 416 North State Street
 Jackson, Mississippi 39201
WATER WELL DRILLERS LOG


9-7-78 Hicks well co TATE
 date well completed firm name county well located

LANDOWNER: <u>Bobby Frazier</u>	description of formations encountered	from	to
<u>PT 3</u>			
<u>Senatobia, Miss.</u> (mailing address)	<u>RC</u>	<u>0</u>	<u>15</u>
WELL LOCATION:	<u>RC & Sand</u>	<u>15</u>	<u>60</u>
sec <u>14</u> T <u>5</u> N R <u>7</u> E	<u>Red Sand</u>	<u>60</u>	<u>80</u>
<u>2</u> miles <u>N</u> of <u>New Town</u>	<u>WS</u>	<u>80</u>	<u>127</u>
(distance) (direction) (nearest town)			
WELL PURPOSE: <u>Home</u> (home, irrigation, municipal, industrial)			
WELL COMPLETION DATA:			
(1) diameter (inches) <u>4"</u>			
(2) total depth (feet) <u>127</u>			
(3) static water level (feet) <u>40</u> below top of ground.			
(4) casing <u>PVC</u> (material) (depth)			
(size) If telescope see back.			
(5) screen <u>7'</u> <u>7'</u> (length) (depth to top)			
<u>4"-02</u> <u>INSIDE ROCK</u> (size) (material)			
(6) pump <u>1/2</u> (HP) (yield gpm)			
<u>220 Elec</u> (type power)			
(7) electric log <u>NO</u> (yes or no)			
(organization running log)			
(8) how well bottom plugged <u>CAP</u>			
DRILLERS REMARKS:			

RECEIVED
 SEP 25 1978
 MISS. BD. OF WATER COM.

If well telescopes please sketch and show depths.

GROUND LEVEL

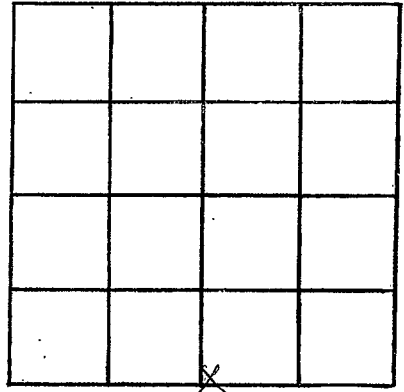

SECTION _____

Please indicate well location X.

ADDITIONAL INFORMATION

If more than one screen,
show locations of each on sketch.