

TATE
G 2044
9-20-78

**MISSISSIPPI  
BOARD OF WATER COMMISSIONERS**  
416 North State Street  
Jackson, Mississippi 39201

**WATER WELL DRILLERS LOG**

9-20-78 Hicks Well Co TATE  
 date well completed                      firm name                      county well located


LANDOWNER: <u>William Taylor</u>	description of formations encountered	from	to
<u>RT-3</u>			
<u>Senobia MISS</u> (mailing address)	<u>Red Clay</u>	<u>0</u>	<u>30</u>
	<u>Gravel &amp; Sand</u>	<u>30</u>	<u>40</u>
	<u>WC SAND</u>	<u>40</u>	<u>90</u>
	<u>WS</u>	<u>90</u>	<u>120</u>
<b>WELL LOCATION:</b>			
sec. <u>14</u> T. <u>5</u> N. R. <u>7</u> E.			
<div style="display: flex; justify-content: space-around;"> <span>(S)</span> <span>(W)</span> </div>			
<u>2 1/2</u> miles <u>N</u> of <u>NEW TOWN</u>			
(distance)                      (direction)                      (nearest town)			
<b>WELL PURPOSE:</b> <u>HOME</u> (home, irrigation, municipal, industrial)			
<b>WELL COMPLETION DATA:</b>			
(1) diameter (inches) <u>4"</u>			
(2) total depth (feet) <u>120</u>			
(3) static water level (feet) <u>40</u> below above top of ground.			
(4) casing <u>PVC</u> , <u>120</u> (material)                      (depth)			
_____ (size) if telescope see back.			
(5) screen <u>7'</u> <u>7'</u> (length)                      (depth to top)			
<u>4" O2</u> , <u>outside brine</u> (size)                      (material)			
(6) pump <u>1/2</u> <u>10</u> (HP)                      (yield gpm)			
<u>220 ELEC</u> (type power)			
(7) electric log <u>NO</u> (yes or no)			
_____ (organization running log)			
(8) how well bottom plugged <u>Cmp</u>			
DRILLERS REMARKS: _____			

**RECEIVED**  
**SEP 25 1978**

MISS. BD. OF WATER COMMISSIONERS

If well telescopes please sketch and show depths.

GROUND LEVEL

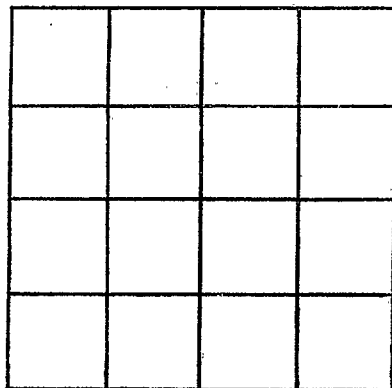

SECTION \_\_\_\_\_

Please indicate well location X.

ADDITIONAL INFORMATION

If more than one screen,  
show locations of each on sketch.