

TATE
 2042 **K 6**
 5/17/78

MISSISSIPPI
 BOARD OF WATER COMMISSIONERS
 416 North State Street
 Jackson, Mississippi 39201

WATER WELL DRILLERS LOG

5-17 1978 Hicks Well Co Tate
 date well completed firm name county well located

LANDOWNER:	description of formations encountered	from	to
<u>Tommy Bailey</u>	<u>Red clay</u>	<u>0</u>	<u>10</u>
<u>Caldwater Ms.</u> (mailing address)	<u>Sand + Gravel</u>	<u>10</u>	<u>90</u>
WELL LOCATION: sec. <u>9</u> T <u>5</u> N R. <u>7</u> E <u>3</u> miles <u>E</u> of <u>Caldwater</u> (distance) (direction) (nearest town)	<u>Red Sand</u>	<u>90</u>	<u>127</u>
WELL PURPOSE: <u>Home</u> (home, irrigation, municipal, industrial)	<u>White Sand</u>	<u>127</u>	<u>165</u>
WELL COMPLETION DATA: (1) diameter (inches) <u>4</u> (2) total depth (feet) <u>165</u> (3) static water level (feet) <u>90</u> below top of ground. (4) casing <u>PVC</u> , <u>165</u> (material) (depth) (size) if telescope see back. (5) screen <u>7</u> , <u>158</u> (length) (depth to top) <u>4</u> , <u>gravel type</u> (size) (material) (6) pump <u>1/2</u> , <u>10</u> (HP) (yield gpm) <u>220V</u> (type power) (7) electric log <u>76</u> (yes or no) (organization running log) (8) how well bottom plugged <u>Cap</u>			
DRILLERS REMARKS:			


RECEIVED

JUN 29 1978

MISS. BD. OF WATER COMMISSIONERS

If well telescopes please sketch and show depths.

GROUND LEVEL

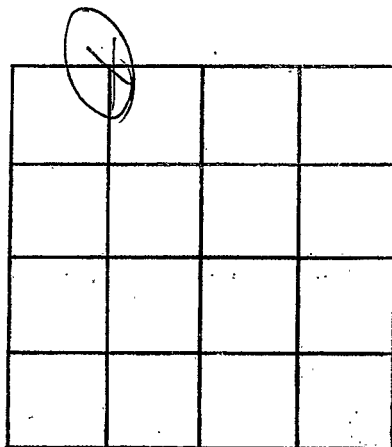

SECTION 9

Please indicate well location X.

ADDITIONAL INFORMATION

If more than one screen,
show locations of each on sketch.