

TATE
G 2013
7-13-78

**MISSISSIPPI
BOARD OF WATER COMMISSIONERS**
416 North State Street
Jackson, Mississippi 39201

WATER WELL DRILLERS LOG

7-13-78 19 date well completed *Bob Littleweese* firm name *Tate* county well located

LANDOWNER:
Wayne Harris
Colchester, Mo.
(mailing address)

WELL LOCATION:
sec. *5* T. *5* N. R. *7* E.
2 miles *E* of *Colchester*
(distance) (direction) (nearest town)

WELL PURPOSE:
(home, irrigation, municipal, industrial)

WELL COMPLETION DATA:

(1) diameter (inches) *4"*

(2) total depth (feet) *170'*

(3) static water level (feet) *130* below top of ground.

(4) casing *plastic* *170'*
(material) (depth)

(size) if telescope see back.

(5) screen *20'* *150'*
(length) (depth to top)

4" *plastic*
(size) (material)

(6) pump *3/4* *10*
(HP) (yield gpm)

E see
(type power)

(7) electric log (yes or no)

(organization running log)

(8) how well bottom *plugged*


description of formations encountered	from	to
<i>top soil</i>	<i>0</i>	<i>5</i>
<i>red clay</i>	<i>5</i>	<i>60</i>
<i>gravel</i>	<i>60</i>	<i>80</i>
<i>sand</i>	<i>80</i>	<i>170</i>

DRILLERS REMARKS:

RECEIVED
NOV 27 1978
MISS. BD. OF WATER COMMISSIONERS

If well telescopes please sketch and show depths.

GROUND LEVEL

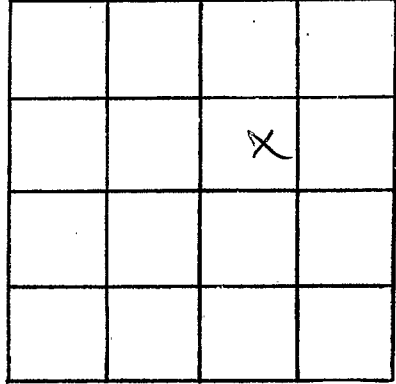

SECTION _____

Please indicate well location X.

ADDITIONAL INFORMATION

If more than one screen, show locations of each on sketch.