

TATE
 G 2044
 2-12-79

MISSISSIPPI
 BOARD OF WATER COMMISSIONERS
 416 North State Street
 Jackson, Mississippi 39201

WATER WELL DRILLERS LOG

2-12-1979 date well completed
 Hicks Well Co firm name
 Tate county well located

LANDOWNER: Reese Walbrump
 Senatobia, Ms.
 (mailing address)

WELL LOCATION:
 sec. 15 T 5 N R 7 E
 2 miles NW of New Town
 (distance) (direction) (nearest town)

WELL PURPOSE: Home
 (home, irrigation, municipal, industrial)

WELL COMPLETION DATA:
 (1) diameter (inches) 4
 (2) total depth (feet) 95
 (3) static water level (feet) 40 below top of ground.
 (4) casing PVC, 95 (material) (depth)
 (size) if telescope see back.
 (5) screen 7, 82 (length) (depth to top)
 4" gravel type (size) (material)
 (6) pump 1/2, 10 (HP) (yield gpm)
 220V (type power)
 (7) electric log No (yes or no)

description of formations encountered	from	to
Clay	0	10
Clay + sand	10	30
white Clay + sand	30	60
white sand	60	95

(organization running log)
 well bottom plugged Cap

REMARKS:


Miss. Board of Water Comm.

FEB 22 1979

RECEIVED

If well telescopes please sketch and show depths.

GROUND LEVEL

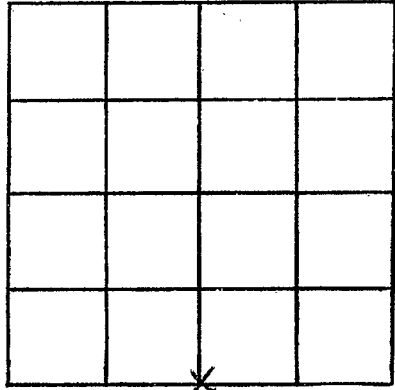

SECTION 15

Please indicate well location X.

ADDITIONAL INFORMATION

If more than one screen, show locations of each on sketch.