

Tate
G 2048
10-3-79

MISSISSIPPI
BOARD OF WATER COMMISSIONERS
416 North State Street
Jackson, Mississippi 39201

WATER WELL DRILLERS LOG

10/13/79 date well completed 19 Bob Smith firm name Tate county well located

LANDOWNER:	description of formations encountered	from	to
<u>Gilly Berry</u> <u>Yadville, Mo.</u> (mailing address)	<u>top soil</u> <u>red clay</u> <u>red sand</u> <u>white sand</u>	<u>0</u> <u>5</u> <u>70</u> <u>100</u>	<u>5</u> <u>40</u> <u>102</u> <u>130</u>
WELL LOCATION: sec. <u>12</u> T. <u>5</u> N. R. <u>7</u> E. <u>3/2</u> miles <u>N.W.</u> of <u>Yadville</u> (distance) (direction) (nearest town)			
WELL PURPOSE: (home, irrigation, municipal, industrial)			
WELL COMPLETION DATA: (1) diameter (inches) <u>4"</u> (2) total depth (feet) <u>130'</u> (3) static water level (feet) <u>100'</u> <u>below</u> top of ground. (4) casing <u>plastic</u> <u>130'</u> (material) (depth) (size) If telescope see back. (5) screen <u>10'</u> <u>100'</u> (length) (depth to top) <u>4"</u> <u>plastic</u> (size) (material) (6) pump <u>1/2</u> <u>10</u> (HP) (yield gpm) <u>elec.</u> (type power) (7) electric log <u>yes</u> (organization running log) (8) how well bottom plugged <u>cap</u>			
DRILLERS REMARKS:			


DEPT. OF NATURAL RESOURCES
BUREAU OF LAND & WATER RESOURCES

DEC 10 1979

RECEIVED

If well telescopes please sketch and show depths.

GROUND LEVEL

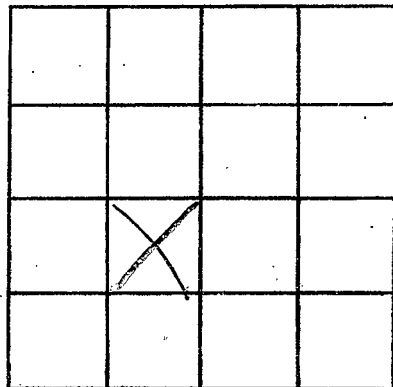

SECTION _____

Please indicate well location X.

ADDITIONAL INFORMATION

If more than one screen,
show locations of each on sketch.