

TATE
G 2050
8/11/79

**MISSISSIPPI
BOARD OF WATER COMMISSIONERS**
416 North State Street
Jackson, Mississippi 39201
WATER WELL DRILLERS LOG


8-11 1979 Hick Woods Co Jato
 date well completed firm name county well located

LANDOWNER:	description of formations encountered	from	to
<u>Johnny Baker</u> <u>Rt. 3, Senatobia</u> (mailing address)			
WELL LOCATION: sec <u>25</u> T <u>S</u> N R <u>7</u> E <u>W</u> <u>10</u> miles <u>E</u> of <u>Senatobia</u> (distance) (direction) (nearest town)	<u>Red Sand</u>	<u>30</u>	<u>60</u>
WELL PURPOSE: <u>Home</u> (home, irrigation, municipal, industrial)	<u>White Sand</u>	<u>60</u>	<u>125</u>
WELL COMPLETION DATA:			
(1) diameter (inches) <u>4 in.</u>			
(2) total depth (feet) <u>125</u>			
(3) static water level (feet) _____ below above top of ground.			
(4) casing <u>PLASTIC</u> , <u>125</u> , (material) (depth) _____ if telescope see back. (size)			
(5) screen <u>7 ft.</u> , <u>118 ft.</u> (length) (depth to top) <u>4 in.</u> , <u>galv.</u> (size) (material)			
(6) pump <u>1/2</u> <u>10</u> (HP) (yield gpm) <u>220</u> (type power)			
(7) electric log <u>NO</u> (yes or no) _____ (organization running log)			
(8) how well bottom plugged <u>CAP</u>			
DRILLERS REMARKS:			

Miss. Board of Water Comm.
AUG 27 1979
RECEIVED

If well telescopes please sketch and show depths.

GROUND LEVEL

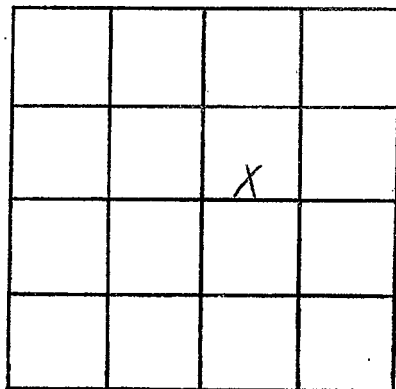

SECTION 25

Please indicate well location X.

ADDITIONAL INFORMATION

If more than one screen,
show locations of each on sketch.