

TAKES

B 2052

6-17-80

6-17

MISSISSIPPI  
 BOARD OF WATER COMMISSIONERS  
 416 North State Street  
 Jackson, Mississippi 39201

WATER WELL DRILLERS LOG

80 Nichols Wells Tate

date well completed

firm name

county well located

LANDOWNER:  
 M&R Construction  
 Senatobia Miss.  
 (mailing address)

description of formations encountered	from	to
clay	0	30
red sand	30	80
white sand	80	112

WELL LOCATION:  
 sec. 22 T. 5 N. R. 7 E.  
 L miles N of New Town  
 (distance) (direction) (nearest town)

WELL PURPOSE: home  
 (home, irrigation, municipal, industrial)

WELL COMPLETION DATA:

(1) diameter (inches) 4 in

(2) total depth (feet) 112

(3) static water level (feet) 60 below above top of ground.

(4) casing Plastic 112 (material) (depth)

(size) if telescope see back.

(5) screen 7 ft 105 (length) (depth to top)

4 in Gravel (size) (material)

(6) pump 1/2 10 (HP) (yield gpm)

220 (type power)

(7) electric log NO (yes or no)

(organization running log)

(8) how well bottom plugged Cap


DRILLERS REMARKS:

DEPT. OF NATURAL RESOURCES  
 BUREAU OF LAND & WATER RESOURCES

JUN 25 1980  
 RECEIVED

If well telescopes please sketch and show depths.

GROUND LEVEL

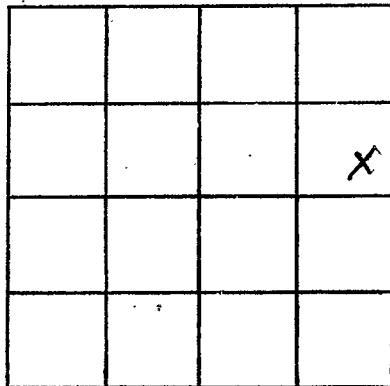

SECTION 22

Please indicate well location X.

ADDITIONAL INFORMATION

If more than one screen,  
show locations of each on sketch.