

MISSISSIPPI DEPARTMENT OF NATURAL RESOURCES

Bureau of Land and Water Resources

Southport Mall

P.O. Box 10631

Jackson, Mississippi 39209

WATER WELL DRILLERS LOG

Date
 G 2053

12-23-80 date well completed
 Bob Smith firm name
 Tate county well located

LANDOWNER:
 J. B. Harris
 Coldwater, Miss.
 (mailing address)

description of formations encountered	from	to
top soil	0	5
red clay	5	60
gravel	60	120
white clay	120	185
white sand	185	210

WELL LOCATION:
 sec. 1 T. 5 N. R. 7 E.
 8 miles E. of Coldwater
 (distance) (direction) (nearest town)

WELL PURPOSE:
 (home, irrigation, municipal, industrial)

WELL COMPLETION DATA:

(1) diameter (inches) 4"

(2) total depth (feet) 210'

(3) static water level (feet) 120' below top of ground.

(4) casing plastic, 210' (material) (depth)
 (size) if telescope see back.

(5) screen 10' 200' (length) (depth to top)
 4" plastic (size) (material)

(6) pump 1/2 10 (HP) (yield gpm)
 elec. (type power)

(7) electric log (yes or no)
 (organization running log)

(8) how well bottom plugged Cap

DEPT. OF NATURAL RESOURCES
 BUREAU OF LAND & WATER RESOURCES


OCT 12 1982

RECEIVED

DRILLERS REMARKS:

If well telescopes please sketch and show depths.

GROUND LEVEL

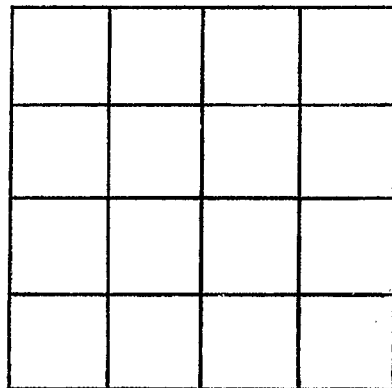

SECTION _____

Please indicate well location X.

ADDITIONAL INFORMATION

If more than one screen,
show locations of each on sketch.