

DATE
 G 2054
 7-28-80

MISSISSIPPI
 BOARD OF WATER COMMISSIONERS
 416 North State Street
 Jackson, Mississippi 39201
 WATER WELL DRILLERS LOG

7-28-1980 date well completed High Well Co firm name Tata county well located

LANDOWNER:	description of formations encountered	from	to
Bethel A.M.E. Church Rt. 1 Senatobia, Miss. (mailing address)			
WELL LOCATION: sec. 25 T 5 N R 7 E 1 miles E of New Town (distance) (direction) (nearest town)			
WELL PURPOSE: Church (home, irrigation, municipal, industrial)			
WELL COMPLETION DATA: (1) diameter (inches) 4 (2) total depth (feet) 140 (3) static water level (feet) 80 below top of ground. (4) casing PVC, 140 (depth) (size) if telescope see back. (5) screen 7' length, 133 (depth to top) 4" (size), gravel type (material) (6) pump 1/2 (HP), 10 (yield gpm) 220V (type power) (7) electric log No (yes or no) (organization running log) (8) how well bottom plugged Cap			
DRILLERS REMARKS:			


DEPT. OF NATURAL RESOURCES
 BUREAU OF LAND & WATER RESOURCES

SEP 26 1980

RECEIVED

If well telescopes please sketch and show depths.

GROUND LEVEL

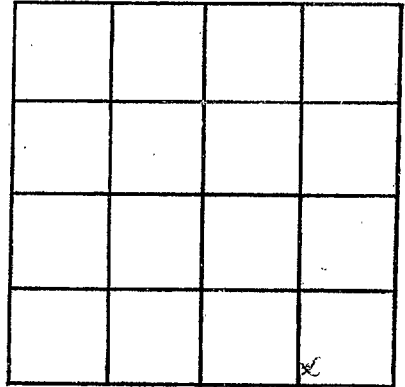

SECTION 25

Please indicate well location X.

ADDITIONAL INFORMATION

If more than one screen,
show locations of each on sketch.