

TATE
G 2055
9-26-80

MISSISSIPPI
BOARD OF WATER COMMISSIONERS
416 North State Street
Jackson, Mississippi 39201

WATER WELL DRILLERS LOG

9-26-80 date well completed Hicks Well Co. firm name Tate county well located


| LANDOWNER: <u>Nathan Anderson</u> <u>Rt. 2</u> | description of formations encountered | from | to |
|--|---------------------------------------|-----------|------------|
| <u>Calderton, Ms.</u> (mailing address) | <u>Red clay</u> | <u>0</u> | <u>10</u> |
| WELL LOCATION: sec. <u>15</u> T <u>5</u> N R <u>7</u> E <u>2</u> miles <u>N</u> of <u>New Town</u> (distance) (direction) (nearest town) | <u>Dravel</u> | <u>10</u> | <u>65</u> |
| WELL PURPOSE: <u>Home</u> (home, irrigation, municipal, industrial) | <u>White sand</u> | <u>65</u> | <u>125</u> |
| WELL COMPLETION DATA: (1) diameter (inches) <u>4</u> (2) total depth (feet) <u>125</u> (3) static water level (feet) <u>60</u> below above top of ground. (4) casing <u>PVC</u> <u>125</u> (material) (depth) ____ (size) if telescope see back. (5) screen <u>7</u> <u>118</u> (length) (depth to top) <u>4"</u> <u>gravel type</u> (size) (material) (6) pump <u>1/2</u> <u>10</u> (HP) (yield gpm) <u>220V</u> (type power) (7) electric log <u>No</u> (yes or no) ____ (organization running log) (8) how well bottom plugged <u>Cap</u> | | | |
| DRILLERS REMARKS: | | | |

DEPT. OF NATURAL RESOURCES
BUREAU OF LAND & WATER RESOURCES

OCT 29 1980
RECEIVED

If well telescopes please sketch and show depths.

GROUND LEVEL

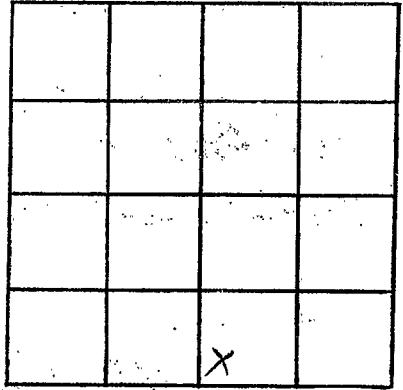

SECTION 15

Please indicate well location X.

ADDITIONAL INFORMATION

If more than one screen,
show locations of each on sketch.