

TATE
G 2054
3-6-80

MISSISSIPPI
BOARD OF WATER COMMISSIONERS
416 North State Street
Jackson, Mississippi 39201

WATER WELL DRILLERS LOG

3/6/80 19 *Bolt/Smith/Log & Tate*
date well completed firm name county well located

LANDOWNER:	description of formations encountered	from	to
<p><i>J. B. Davis</i> <i>Colquhoun Dr</i> (mailing address)</p>	<p><i>top soil</i> <i>red clay</i> <i>gravel</i> <i>blue clay</i> <i>white sand</i></p>	<p><i>0</i> <i>5</i> <i>20</i> <i>20</i> <i>140</i></p>	<p><i>3</i> <i>40</i> <i>60</i> <i>140</i> <i>180</i></p>
<p>WELL LOCATION: sec. <i>4</i> T <i>5</i> N R <i>7</i> E <i>2 1/4</i> miles <i>E</i> <i>Coaldale</i> (distance) (direction) (nearest town)</p>			
<p>WELL PURPOSE: (home, irrigation, municipal, industrial)</p>			
<p>WELL COMPLETION DATA:</p> <p>(1) diameter (inches) <i>4"</i></p> <p>(2) total depth (feet) <i>180'</i></p> <p>(3) static water level (feet) <i>100'</i> below above top of ground.</p> <p>(4) casing <i>plastic</i>, <i>80'</i> (material) (depth)</p> <p>_____ If telescope see back. (size)</p> <p>(5) screen <i>10'</i>, <i>180'</i> (length) (depth to top)</p> <p><i>4"</i>, <i>plastic</i> (size) (material)</p> <p>(6) pump <i>1/2</i>, <i>10</i> (HP) (yield gpm)</p> <p><i>elec.</i> (type power)</p> <p>(7) electric log _____ (yes or no)</p> <p>_____ (organization running log)</p> <p>(8) how well bottom plugged <i>Cap</i></p>			
<p>DRILLERS REMARKS:</p>			


DEPT. OF NATURAL RESOURCES
BUREAU OF LAND & WATER RESOURCES

OCT 15 1980

RECEIVED

If well telescopes please sketch and show depths.

GROUND LEVEL

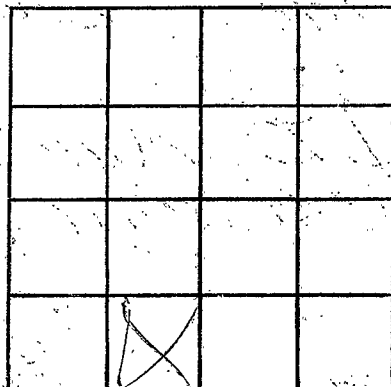

SECTION _____

Please indicate well location X.

ADDITIONAL INFORMATION

If more than one screen,
show locations of each on sketch.