

TATE
 G 2057
 10-2-80

MISSISSIPPI
 BOARD OF WATER COMMISSIONERS
 416 North State Street
 Jackson, Mississippi 39201

WATER WELL DRILLERS LOG

10-2-80 date well completed Hids Well Co. firm name Tate county well located

LANDOWNER: <u>Hutsen Atkins</u>	description of formations encountered	from	to
<u>Rt. 2</u>	<u>Red clay</u>	<u>0</u>	<u>10</u>
<u>Coldwater, Ms.</u> (mailing address)	<u>Clay + sand</u>	<u>10</u>	<u>20</u>
WELL LOCATION: sec <u>4</u> T <u>5</u> N R <u>9</u> E <u>1</u> miles <u>SE</u> of <u>Coldwater</u> (distance) (direction) (nearest town)	<u>White sand</u>	<u>20</u>	<u>110</u>
WELL PURPOSE: <u>Home</u> (home, irrigation, municipal, industrial)			
WELL COMPLETION DATA:			
(1) diameter (inches) <u>4</u>			
(2) total depth (feet) <u>110</u>			
(3) static water level (feet) <u>60</u> below top of ground.			
(4) casing <u>PVC</u> <u>110</u> (material) (depth)			
_____ if telescope see back. (size)			
(5) screen <u>7'</u> <u>103</u> (length) (depth to top)			
<u>4"</u> <u>gravel type</u> (size) (material)			
(6) pump <u>1/2</u> <u>10</u> (HP) (yield gpm)			
<u>220V</u> (type power)			
(7) electric log <u>No</u> (yes or no)			
_____ (organization running log)			
(8) how well bottom plugged <u>Cap</u>			
DRILLERS REMARKS:			


DEPT. OF NATURAL RESOURCES
 BUREAU OF LAND & WATER RESOURCES

OCT 29 1980

RECEIVED

If well telescopes please sketch and show depths.

GROUND LEVEL

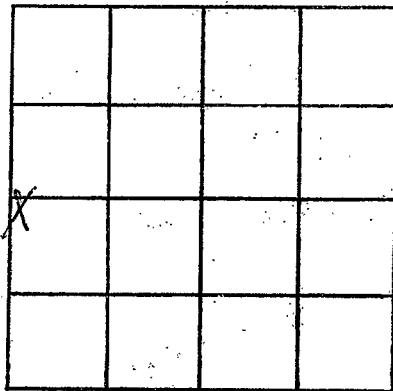

SECTION 4

Please indicate well location X.

ADDITIONAL INFORMATION

If more than one screen,
show locations of each on sketch.