

TATE  
G 2052  
2-20-80

MISSISSIPPI  
BOARD OF WATER COMMISSIONERS  
416 North State Street  
Jackson, Mississippi 39201

WATER WELL DRILLERS LOG

2/20 1980 BOB Smith Well Sec. Tate  
date well completed firm name county well located

LANDOWNER: Richard Burns  
Coldwater, Miss.  
(mailing address)

description of formations encountered	from	to
top soil	0	5
red clay	5	40
white sand	40	110

WELL LOCATION:  
sec. 4 T 4 N R 7 E  
2 miles S.E. of Coldwater  
(distance) (direction) (nearest town)

WELL PURPOSE:  
(home, irrigation, municipal, industrial)

WELL COMPLETION DATA:

(1) diameter (inches) 4"

(2) total depth (feet) 110'

(3) static water level (feet) 75' below top of ground.

(4) casing plastic 110'  
(material) (depth)

(size) If telescope see back.

(5) screen 10' 110'  
(length) (depth to top)

4" plastic  
(size) (material)

(6) pump 1/2 10  
(HP) (yield gpm)

elec.  
(type power)

(7) electric log (yes or no)

(organization running log)

(8) how well bottom plugged Cap

DEPT. OF NATURAL RESOURCES  
BUREAU OF LAND & WATER RESOURCES


OCT 15 1980

RECEIVED

DRILLERS REMARKS:

If well telescopes please sketch and show depths.

GROUND LEVEL

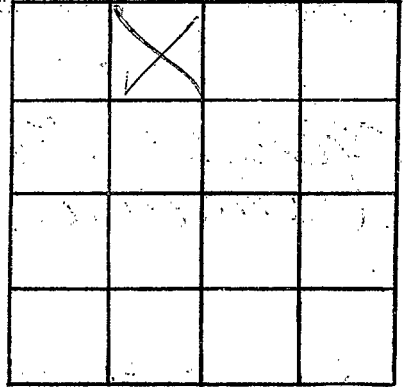

SECTION \_\_\_\_\_

Please indicate well location X.

ADDITIONAL INFORMATION

If more than one screen, show locations of each on sketch.