

MISSISSIPPI DEPARTMENT OF NATURAL RESOURCES

Bureau of Land and Water Resources

Southport Mall

P.O. Box 10631

Jackson, Mississippi 39209

WATER WELL DRILLERS LOG

TATE
G 2059
1-14-81

1-14 1981 date well completed High Well Co. firm name Tate county well located


LANDOWNER: <u>C. Jones</u>	description of formations encountered	from	to
<u>Coldivater, Ms.</u> (mailing address)	<u>Red Clay</u>	<u>8</u>	<u>10</u>
WELL LOCATION: sec. <u>5</u> T. <u>5</u> N. R. <u>7</u> E. <u>1/4</u> miles <u>E</u> of <u>Coldivater</u> (distance) (direction) (nearest town)	<u>White Sand</u>	<u>10</u>	<u>140</u>
WELL PURPOSE: <u>Home</u> (home, irrigation, municipal, industrial)			
WELL COMPLETION DATA: (1) diameter (inches) <u>4</u> (2) total depth (feet) <u>140</u> (3) static water level (feet) <u>20</u> below above top of ground. (4) casing <u>PVC</u> <u>140</u> (material) (depth) <u> </u> if telescope see back. (size) (5) screen <u>7</u> <u>1.33</u> (length) (depth to top) <u>2 1/2"</u> <u>steel type</u> (size) (material) (6) pump <u>1/2</u> <u>10</u> (HP) (yield gpm) <u>220V</u> (type power) (7) electric log <u>No</u> (yes or no) <u> </u> (organization running log) (8) how well bottom plugged <u>Cup</u>			
DRILLERS REMARKS:			

DEPT. OF NATURAL RESOURCES
BUREAU OF LAND & WATER RESOURCES

FEB 12 1981
RECEIVED

If well telescopes please sketch and show depths.

GROUND LEVEL

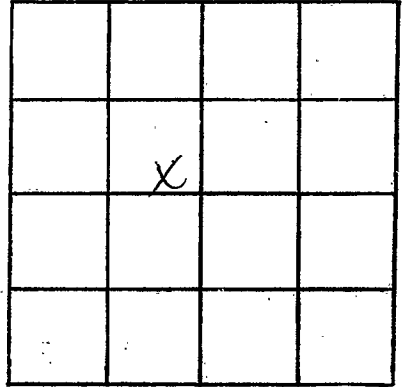

SECTION 5

Please indicate well location X.

ADDITIONAL INFORMATION

If more than one screen,
show locations of each on sketch.