

MISSISSIPPI DEPARTMENT OF NATURAL RESOURCES

Bureau of Land and Water Resources

Southport Mall

P.O. Box 10631

Jackson, Mississippi 39209

WATER WELL DRILLERS LOG

Lata  
G 2000  
6-30-81


6-30 19 81 Hicks Well Co. Tata  
 date well completed firm name county well located

LANDOWNER: <u>Neil Billingsley</u> <u>Rt. 3</u>	description of formations encountered	from	to
<u>Senatobia, Mo.</u> (mailing address)	<u>Red clay</u>	<u>0</u>	<u>15</u>
WELL LOCATION: sec. <u>22</u> T. <u>5</u> N. R. <u>7</u> E. <u>3</u> miles <u>W</u> of <u>Newtown</u> (distance) (direction) (nearest town)	<u>Red sand</u>	<u>15</u>	<u>45</u>
WELL PURPOSE: <u>Home</u> (home, irrigation, municipal, industrial)	<u>White sand</u>	<u>45</u>	<u>125</u>
WELL COMPLETION DATA: (1) diameter (inches) <u>4"</u>			
(2) total depth (feet) <u>125'</u>			
(3) static water level (feet) <u>60'</u> below above top of ground.			
(4) casing <u>PVC</u> , <u>125'</u> (material) (depth)			
_____ If telescope see back. (size)			
(5) screen <u>7'</u> , <u>118'</u> (length) (depth to top)			
<u>4"</u> , <u>gravel type</u> (size) (material)			
(6) pump <u>1/2</u> , <u>10</u> (HP) (yield gpm)			
<u>220V</u> (type power)			
(7) electric log <u>No</u> (yes or no)			
_____ (organization running log)			
(8) how well bottom plugged <u>Cap</u>			
DRILLERS REMARKS:			



If well telescopes please sketch and show depths.

GROUND LEVEL

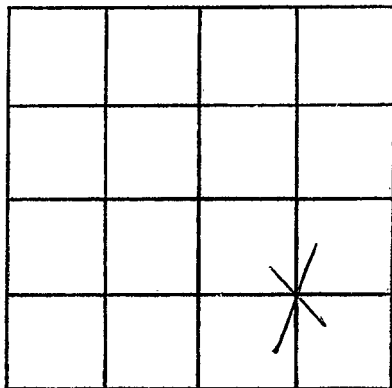

SECTION 29

Please indicate well location X.

ADDITIONAL INFORMATION

If more than one screen,  
show locations of each on sketch.