

MISSISSIPPI DEPARTMENT OF NATURAL RESOURCES

Bureau of Land and Water Resources

Southport Mall

P.O. Box 10631


Jackson, Mississippi 39209

WATER WELL DRILLERS LOG

Lab
G 2001
7-8-81

7-8 1981 date well completed Hicks Well Co firm name Tate county well located

LANDOWNER: <u>Steve Red</u>	description of formations encountered	from	to
<u>Box 3</u> <u>Senatobia, Mo.</u> (mailing address)			
WELL LOCATION: sec. <u>14</u> T <u>5</u> N R. <u>2</u> E <u>3</u> miles <u>N</u> of <u>Newton</u> (distance) (direction) (nearest town)	<u>Red clay</u>	<u>0</u>	<u>20</u>
WELL PURPOSE: <u>Home</u> (home, irrigation, municipal, industrial)	<u>white clay sand</u>	<u>20</u>	<u>65</u>
WELL COMPLETION DATA: (1) diameter (inches) <u>4</u>	<u>white sand</u>	<u>65</u>	<u>140</u>
(2) total depth (feet) <u>140</u>			
(3) static water level (feet) <u>100</u> below top of ground.			
(4) casing <u>PVC</u> , <u>140</u> (material) (depth)			
<u> </u> If telescope see back. (size)			
(5) screen <u>7</u> , <u>133</u> (length) (depth to top)			
<u>4"</u> , <u>gravel type</u> (size) (material)			
(6) pump <u>1/2</u> , <u>10</u> (HP) (yield gpm)			
<u>220V</u> (type power)			
(7) electric log <u>No</u> (yes or no)			
<u> </u> (organization running log)			
(8) how well bottom plugged <u>Cap</u>			
DRILLERS REMARKS:			

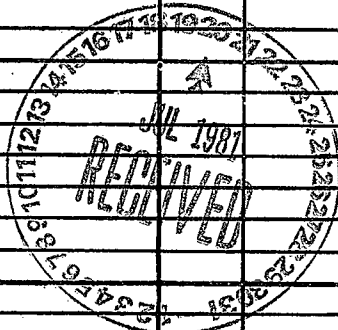

If well telescopes please sketch and show depths.

GROUND LEVEL

			X

SECTION 14

Please indicate well location X.

ADDITIONAL INFORMATION

If more than one screen,
show locations of each on sketch.