

MISSISSIPPI DEPARTMENT OF NATURAL RESOURCES

Bureau of Land and Water Resources

Southport Mall

P.O. Box 10631

Jackson, Mississippi 39209

WATER WELL DRILLERS LOG


Date
G 2062
7-24-81

7-24-81 date well completed 1981 Hick Well Co. firm name Tates county well located

LANDOWNER	description of formations encountered	from	to
James Mr. Abney Rt. 3	Red Clay	0	20
Senator's Mrs. (mailing address)	Red Sand	20	95
WELL LOCATION: sec. 16 T 5 N R 2 E 3 miles S W of New Town (distance) (direction) (nearest town)	White Sand	95	138
WELL PURPOSE: Home (home, irrigation, municipal, industrial)			
WELL COMPLETION DATA:			
(1) diameter (inches) 4			
(2) total depth (feet) 138			
(3) static water level (feet) 90 below top of ground.			
(4) casing PVC, 138 (material) (depth)			
(5) screen 12, 126 (length) (depth to top)			
4" gravel + PVC (size) (material)			
(6) pump 1/2, 10 (HP) (yield gpm)			
220V (type power)			
(7) electric log No (yes or no)			
(organization running log)			
(8) how well bottom plugged Cap			
DRILLERS REMARKS:			

If well telescopes please sketch and show depths.

GROUND LEVEL

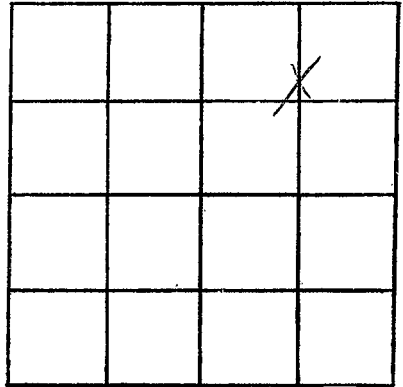

SECTION 16

Please indicate well location X.

ADDITIONAL INFORMATION

Lined area for additional information.

If more than one screen, show locations of each on sketch.