

MISSISSIPPI DEPARTMENT OF NATURAL RESOURCES
Bureau of Land and Water Resources
 Southport Mall
 P.O. Box 10631

Jackson, Mississippi 39209
WATER WELL DRILLERS LOG

TATE
G 2263
10-12-81

HICKS WELL COMPANY

10-12-81 date well completed RT. 1 BOX 157 firm name Tate county well located

LANDOWNER: Mavin Whaler
324 S. Mavin St.
Senatoria, Ms.
 (mailing address) 39668

description of formations encountered	from	to
Red Clay	0	20
Red sand	20	40
Gravel	40	80
White Sand & Clay	80	140
White sand	140	170

WELL LOCATION:
 sec. 11 T. 5 N. R. 7 E.
4 miles N of New Town
 (distance) (direction) (nearest town)

WELL PURPOSE: Home
 (home, irrigation, municipal, industrial)

WELL COMPLETION DATA:

- (1) diameter (inches) 4
- (2) total depth (feet) 170
- (3) static water level (feet) 80 below above top of ground.
- (4) casing PVC 170
 (material) (depth)
- (size) if telescope see back.
- (5) screen 7 163
 (length) (depth to top)
- 4" gravel type
 (size) (material)
- (6) pump 1/2 10
 (HP) (yield gpm)
- 220V
 (type power)
- (7) electric log No
 (yes or no)
- (8) how well bottom plugged Cap
 (organization running log)

DRILLERS REMARKS:


DEPT. OF NATURAL RESOURCES
 BUREAU OF LAND & WATER RESOURCES

OCT 16 1981

RECEIVED

If well telescopes please sketch and show depths.

GROUND LEVEL

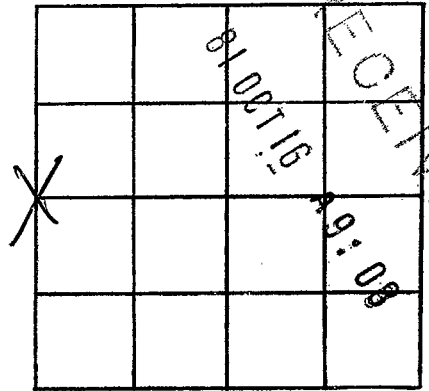

SECTION 11

Please indicate well location X.

ADDITIONAL INFORMATION

If more than one screen,
show locations of each on sketch.