

MISSISSIPPI DEPARTMENT OF NATURAL RESOURCES
Bureau of Land and Water Resources
 Southport Mall
 P.O. Box 10631
 Jackson, Mississippi 39209
WATER WELL DRILLERS LOG

TATE
G 2005
11-19-81

11-19-81 HICKS WELL COMPANY Tate
 date well completed 1-BOX 157 name county well located

LANDOWNER: <u>E. P. Donald, Jr.</u>	MISS. description of formations encountered	from	to
<u>Box 3 Box 364</u>	<u>Red Clay</u>	<u>0</u>	<u>20</u>
<u>Sherwood, Mo.</u> (mailing address) <u>38668</u>	<u>Red Sand</u>	<u>20</u>	<u>80</u>
WELL LOCATION: sec. <u>15</u> <u>S</u> <u>N</u> R. <u>2</u> <u>E</u> <u>W</u>	<u>Red Sand + White Sand</u>	<u>80</u>	<u>125</u>
<u>2</u> miles <u>N</u> of <u>Newtown</u>	<u>White Sand + Clay</u>	<u>125</u>	<u>160</u>
(distance) (direction) (nearest town)	<u>White Sand</u>	<u>160</u>	<u>185</u>

WELL PURPOSE: Home
 (home, irrigation, municipal, industrial)

WELL COMPLETION DATA:

- (1) diameter (inches) 4
- (2) total depth (feet) 185
- (3) static water level (feet) 140 below above top of ground.
- (4) casing PVC, 185,
 (material) (depth)
- If telescope see back.
 (size)
- (5) screen 10, 175
 (length) (depth to top)
- 4", PVC Slotted
 (size) (material)
- (6) pump 1/2, 10
 (HP) (yield gpm)
- 220V
 (type power)
- (7) electric log No
 (yes or no)
- (organization running log)
- (8) how well bottom plugged Cap


DRILLERS REMARKS:

DEPT. OF NATURAL RESOURCES
 BUREAU OF LAND & WATER RESOURCES
 NOV 30 1981

RECEIVED

If well telescopes please sketch and show depths.

GROUND LEVEL

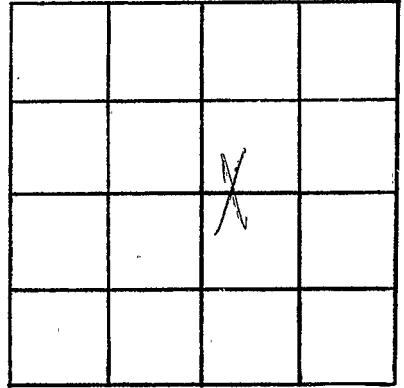

SECTION 15

Please indicate well location X.

ADDITIONAL INFORMATION

If more than one screen,
show locations of each on sketch.