

MISSISSIPPI DEPARTMENT OF NATURAL RESOURCES

Bureau of Land and Water Resources

Southport Mall

P.O. Box 10631

Jackson, Mississippi 39209

WATER WELL DRILLERS LOG

Date
G
2007

HICKS WELL COMPANY

106

5-4 1982
date well completed

HICKS name

county well located

LANDOWNER:	description of formations encountered	from	to
Allen Traywick Box 2 Box 9 Coldwater, Miss. (mailing address) 38618	Red Clay	0	10
	Red Sand	10	20
WELL LOCATION: sec. 4 T. 5 N. R. 7 E. 1 miles SE of Coldwater (distance) (direction) (nearest town)	Sand	20	60
	White Sand + Clay	60	125
WELL PURPOSE: Home (home, irrigation, municipal, industrial)	White Sand	125	160
WELL COMPLETION DATA: (1) diameter (inches) 4			
(2) total depth (feet) 160			
(3) static water level (feet) 120 below above top of ground.			
(4) casing PVC, 160, (material) (depth)			
(size) if telescope see back.			
(5) screen 10, 150 (length) (depth to top)			
010, PVC (size) (material)			
(6) pump 1/2, 10 (HP) (yield gpm)			
220V (type power)			
(7) electric log No (yes or no)			
(organization running log)			
(8) how well bottom plugged Cap			
DRILLERS REMARKS:			


DEPT. OF NATURAL RESOURCES
BUREAU OF LAND & WATER RESOURCES

MAY 10 1992

RECEIVED

If well telescopes please
sketch and show depths.

GROUND LEVEL

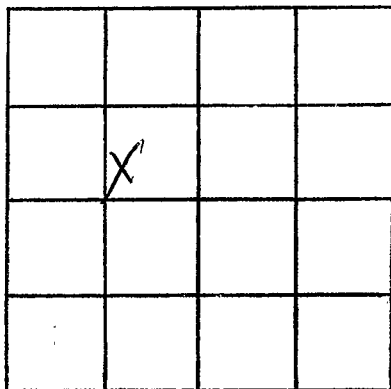

SECTION 4

Please indicate well location X.

ADDITIONAL INFORMATION

If more than one screen,
show locations of each on sketch.