

MISSISSIPPI DEPARTMENT OF NATURAL RESOURCES

Bureau of Land and Water Resources

Southport Mall

P.O. Box 10631

Jackson, Mississippi 39209

WATER WELL DRILLERS LOG

HICKS WELL CO.
Rt 1 Box 157

Senatobia, MS 38668

Date
G
2008

7-29 1982
date well completed

Jato
county well located

LANDOWNER: Lundy Daniel
6439 Kirby Ridge Cove
Memphis, Tenn.
(mailing address)

description of formations encountered

from to

WELL LOCATION:
sec. 27 T 5 N R 7 E
1/4 miles N of Newton
(distance) (direction) (nearest town)

Red clay

0 20

Black Clay

20 90

White sand

90 140

WELL PURPOSE: Home
(home, irrigation, municipal, industrial)

WELL COMPLETION DATA:

- (1) diameter (inches) 4"
- (2) total depth (feet) 140
- (3) static water level (feet) 75 ^{below} above top of ground.
- (4) casing PVC, 140,
(material) (depth)
4"
(size) If telescope see back.
- (5) screen 10', 130
(length) (depth to top)
813, PVC
(size) (material)
- (6) pump 1/2, 10
(HP) (yield gpm)
220V
(type power)
- (7) electric log No
(yes or no)

(organization running log)

(8) how well bottom plugged Cap


DRILLERS REMARKS:

SEPT. OF NATURAL RESOURCES
BUREAU OF LAND & WATER RESOURCES

AUG - 4 1982
RECEIVED

If well telescopes please sketch and show depths.

GROUND LEVEL

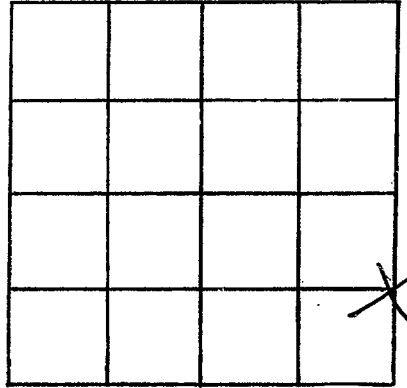

SECTION 27

Please indicate well location X.

ADDITIONAL INFORMATION

If more than one screen,
show locations of each on sketch.