

MISSISSIPPI DEPARTMENT OF NATURAL RESOURCES

Bureau of Land and Water Resources

Southport Mall

P.O. Box 10631

Jackson, Mississippi 39209

WATER WELL DRILLERS LOG

Date
G
2009

5-15-82 19

Bak Smith

Tate

date well completed

firm name

county well located

LANDOWNER:  
H.L. Gardner  
Coldwater, Ms  
 (mailing address)

description of formations encountered	from	to
top soil	0	5
red clay	5	33
white clay	33	69
gravel	69	120
sand	120	202

WELL LOCATION:  
 sec. 8 T. 5 N. R. 7 E.  
 (S) (W)  
5 miles S. of Coldwater  
 (distance) (direction) (nearest town)

WELL PURPOSE:  
 (home, irrigation, municipal, industrial)

WELL COMPLETION DATA:  
 (1) diameter (inches) 4"  
 (2) total depth (feet) 202'  
 (3) static water level (feet) 90'  below  above top of ground.  
 (4) casing plastic  
 (material) (depth)  
 \_\_\_\_\_ if telescope see back.  
 (size)  
 (5) screen 20' 182'  
 (length) (depth to top)  
4" plastic  
 (size) (material)  
 (6) pump 1/2 10  
 (HP) (yield gpm)  
elec.  
 (type power)  
 (7) electric log  (yes or no)

\_\_\_\_\_ (organization running log)  
 (8) how well bottom plugged cap

DRILLERS REMARKS:


DEPT. OF NATURAL RESOURCES  
BUREAU OF LAND & WATER RESOURCES

OCT 12 1982

RECEIVED

If well telescopes please sketch and show depths.

GROUND LEVEL

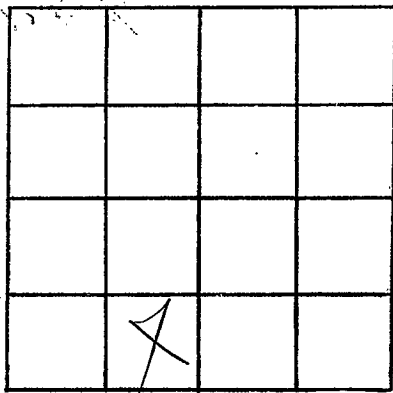

SECTION \_\_\_\_\_

Please indicate well location X.

ADDITIONAL INFORMATION

If more than one screen,  
show locations of each on sketch.