

MISSISSIPPI DEPARTMENT OF NATURAL RESOURCES

Bureau of Land and Water Resources

Southport Mall

P.O. Box 10631

Jackson, Mississippi 39209

WATER WELL DRILLERS LOG

Date  
G  
2011

12/5 1983  
date well completed

MICKS WELL CO.  
firm name  
Senators, Ms. 38668

Tate  
county well located

LANDOWNER: Robert Latham  
P.O. Box 681  
Senators, Ms. 38668  
(mailing address)

WELL LOCATION:  
sec. 15 T 5 N R 2 E  
2 miles N of Newton  
(distance) (direction) (nearest town)

WELL PURPOSE: Home  
(home, irrigation, municipal, industrial)

- WELL COMPLETION DATA:
- (1) diameter (inches) 4
  - (2) total depth (feet) 110
  - (3) static water level (feet) 60 <sup>below</sup> top of ground.
  - (4) casing PVC, 110, (material) (depth)  
4' (size) if telescope see back.
  - (5) screen 10', 150 (length) (depth to top)  
.010 PVC (size) (material)
  - (6) pump 1/2, 10 (HP) (yield gpm)  
2200 (type power)
  - (7) electric log No (yes or no)
  - (8) organization running log
  - (8) how well bottom plugged Cap

description of formations encountered	from	to
Red Clay	0	20
Red Sand + white clay	20	50
white sand + clay	50	80
white sand	80	110

DEPT. OF NATURAL RESOURCES  
BUREAU OF LAND & WATER RESOURCES


JAN 9 - 1984

RECEIVED

DRILLERS REMARKS:

If well telescopes please sketch and show depths.

GROUND LEVEL

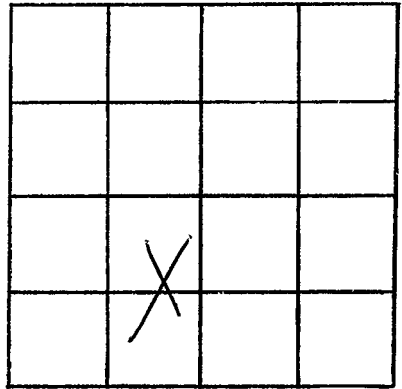

SECTION 15

Please indicate well location X.

ADDITIONAL INFORMATION

If more than one screen, show locations of each on sketch.