

MISSISSIPPI DEPARTMENT OF NATURAL RESOURCES

Bureau of Land and Water Resources

Southport Mall

P.O. Box 10631

Jackson, Mississippi 39209

WATER WELL DRILLERS LOG

Date  
G  
2072

3/14 1984  
date well completed

HICKS WELL CO.  
firm name, BOX 157  
Saratobia, MS 38668

Tate  
county well located

LANDOWNER: James Scurlock  
P.O. #1  
Saratobia, Ms. 38668  
(mailing address)

description of formations encountered

WELL LOCATION:  
sec. 35 S 5 N R 2 E W  
1 miles S of New Town  
(distance) (direction) (nearest town)

description of formations encountered	from	to
Red Clay	0	20
Red sand	20	50
Gravel	50	110
White Sand	110	125

WELL PURPOSE: Home  
(home, irrigation, municipal, industrial)

WELL COMPLETION DATA:

- (1) diameter (inches) 4
- (2) total depth (feet) 125
- (3) static water level (feet) 100 below above top of ground.
- (4) casing PVC 125 (material) (depth)  
4" (size) if telescope see back.
- (5) screen 10' 115 (length) (depth to top)  
.010 PVC (size) (material)
- (6) pump 1/2 10 (HP) (yield gpm)  
220V (type power)
- (7) electric log No (yes or no)  
(organization running log)
- (8) how well bottom plugged Cop

DRILLERS REMARKS:


DEPT. OF NATURAL RESOURCES  
BUREAU OF LAND & WATER RESOURCES

APR 16 1984

RECEIVED

If well telescopes please sketch and show depths.

GROUND LEVEL

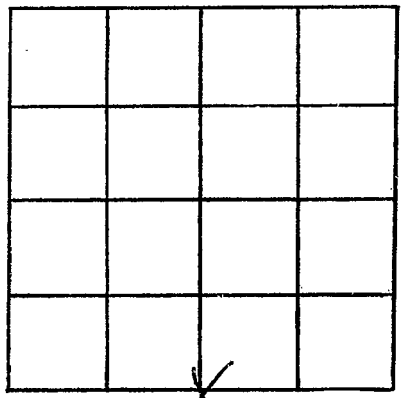

SECTION 35

Please indicate well location X.

ADDITIONAL INFORMATION

Lined area for additional information.

If more than one screen, show locations of each on sketch.