

MISSISSIPPI DEPARTMENT OF NATURAL RESOURCES

Bureau of Land and Water Resources

Southport Mall

P.O. Box 10631

Jackson, Mississippi 39209

WATER WELL DRILLERS LOG

HICKS WELL CO.

firm name
Senatobia, MS 38686

Tate

8-2 1984
date well completed

county well located

LANDOWNER: Henry Wooten
Rt. 2

description of formations encountered

from to

Coldwater, R. 38618
(mailing address)

Red Clay

0 10

Red Sand

10 40

WELL LOCATION:

sec. 9 T 5 N R 2 E
3 miles SE of Coldwater
(distance) (direction) (nearest town)

Gravel

40 100

White Clay & sand

100 130

WELL PURPOSE: Home
(home, irrigation, municipal, industrial)

White Sand

130 170

WELL COMPLETION DATA:

(1) diameter (inches) 4
(2) total depth (feet) 170
(3) static water level (feet) 120 below above top of ground.

(4) casing PVC, 170,
(material) (depth)
4"
(size) if telescope see back.

(5) screen 10', 160
(length) (depth to top)
.010, PVC
(size) (material)

(6) pump 1/2, 10
(HP) (yield gpm)
220V
(type power)

(7) electric log No
(yes or no)

(organization running log)

(8) how well bottom plugged Cap

DRILLERS REMARKS:


DEPT. OF NATURAL RES.
BUREAU OF LAND & WATER RES.

SEP 24 1984

RECEIVED

If well telescopes please sketch and show depths.

GROUND LEVEL

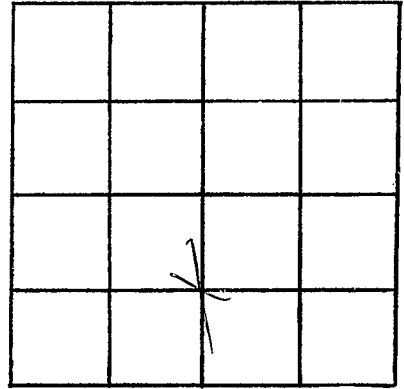

SECTION 9

Please indicate well location X.

ADDITIONAL INFORMATION

If more than one screen, show locations of each on sketch.