

MISSISSIPPI DEPARTMENT OF NATURAL RESOURCES
Bureau of Land and Water Resources
 Southport Mall
 P.O. Box 10631
 Jackson, Mississippi 39209
WATER WELL DRILLERS LOG

G 2014
 TATE
 8-20-85

5142

8-20 1985 Gamer House Well Co. TATE
 date well completed firm name county well located

LANDOWNER: Mike Sansom
P.O. Box 981
Senobia Miss 38668
 (mailing address)

description of formations encountered	from	to
Brown Clay	0	25
Shale	25	50
White Clay	50	60
White Sand	60	175

WELL LOCATION:
 sec. 10 T S N R 2 E
3 miles East of Coldwater
 (distance) (direction) (nearest town)

WELL PURPOSE:
 Home, Irrigation, municipal, industrial

WELL COMPLETION DATA:

(1) diameter (inches) 4

(2) total depth (feet) 175

(3) static water level (feet) 125 below above top of ground.

(4) casing Plastic 165
 (material) (depth)

 if telescope see back.
 (size)

(5) screen 10 165
 (length) (depth to top)

4 Plastic
 (size) (material)

(6) pump 1 20
 (HP) (yield gpm)

electric
 (type power)

(7) electric log
 (yes or no)

 (organization running log)

(8) how well bottom plugged 4"
Plastic Cap

DRILLERS REMARKS:


RECEIVED

SEP 30 1985

Department of Natural Resources
 Bureau of Land & Water Resources

If well telescopes please sketch and show depths.

GROUND LEVEL

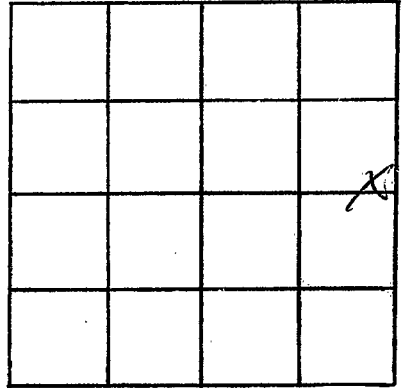

SECTION 10

Please indicate well location X.

ADDITIONAL INFORMATION

If more than one screen,
show locations of each on sketch.