

MISSISSIPPI DEPARTMENT OF NATURAL RESOURCES

Bureau of Land and Water Resources

Southport Mall

P.O. Box 10631

Jackson, Mississippi 39209

WATER WELL DRILLERS LOG

HICKS WELL COMPANY

TATE
G
2075

11-1 1985
date well completed

RT. 1 BOX 157
firm name

Yate
county well located

SENATORIA, MISS

LANDOWNER: Curley Jones

description of formations encountered	from	to
red clay	0	10
shovel of red sand	10	30
white sand	30	110

Caldwater MS 38668
(mailing address)

WELL LOCATION:

sec 32 T 5 N R 7 E
S W
_____ miles _____ of Caldwater
(distance) (direction) (nearest town)

WELL PURPOSE: Home
(home, irrigation, municipal, industrial)

WELL COMPLETION DATA:

- (1) diameter (inches) 4"
- (2) total depth (feet) 110'
- (3) static water level (feet) 60' below above top of ground.
- (4) casing PVC 100'
(material) (depth)
4" if telescope see back.
(size)
- (5) screen 10' 100'
(length) (depth to top)
.013 PVC
(size) (material)
- (6) pump 1/2 10
(HP) (yield gpm)
220V
(type power)
- (7) electric log NO
(yes or no)

(organization running log)

(8) how well bottom plugged Cap


DRILLERS REMARKS:

RECEIVED
DEC 26 1985

Department of Natural Resources
Bureau of Land & Water Resources

If well telescopes please sketch and show depths.

GROUND LEVEL

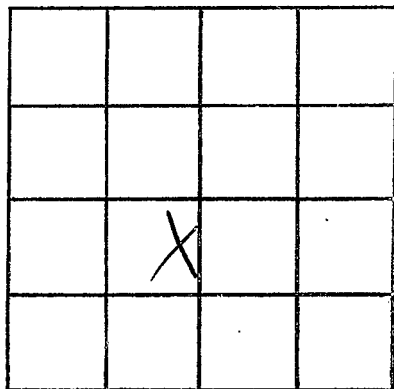

SECTION 32

Please indicate well location X.

ADDITIONAL INFORMATION

If more than one screen, show locations of each on sketch.