

MISSISSIPPI DEPARTMENT OF NATURAL RESOURCES

Bureau of Land and Water Resources

Southport Mall

P.O. Box 10631

Jackson, Mississippi 39209

WATER WELL DRILLERS LOG

TATE
G
007

3-5

1986 Gullett Water Well

Tate

date well completed

firm name

county well located

LANDOWNER: Robert Hope
 Poagville Rd.
 Coldwater, Ms
 (mailing address)

description of formations encountered

from

to

Top Soil	0	2
Clay	2	30
Red sand gravel	30	60
White Clay	60	70
White sand	70	175

WELL LOCATION:

sec. 2 T 5 N R 7 E
 3 miles west of Poagville
 (distance) (direction) (nearest town)

WELL PURPOSE: Home
 (home, irrigation, municipal, industrial)

WELL COMPLETION DATA:

- (1) diameter (inches) 4"
- (2) total depth (feet) 175'
- (3) static water level (feet) 130' below top of ground.
- (4) casing PVC, 115' (material) (depth)
 4" (size) If telescope see back.
- (5) screen 10' (length), 165' (depth to top)
 4" (size) PVC (material)
- (6) pump 3/4 (HP), 10 (yield gpm)
 Elec (type power)
- (7) electric log No (yes or no)
- (organization running log)
- (8) how well bottom plugged Cap


MISSISSIPPI DEPARTMENT OF NATURAL RESOURCES
 BUREAU OF LAND AND WATER RESOURCES
 APR 28 1986

DRILLERS REMARKS:

Department of Natural Resources
 Bureau of Land and Water Resources

If well telescopes please sketch and show depths.

GROUND LEVEL

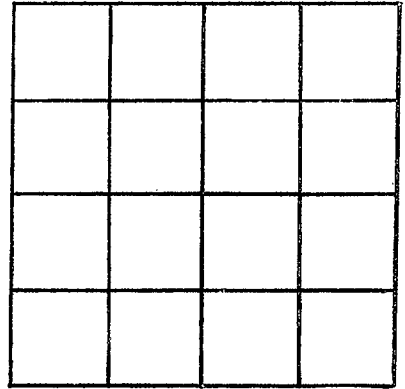

SECTION _____

Please indicate well location X.

ADDITIONAL INFORMATION

If more than one screen,
show locations of each on sketch.