

MISSISSIPPI DEPARTMENT OF NATURAL RESOURCES

Bureau of Land and Water Resources

Southport Mall

P.O. Box 10631

Jackson, Mississippi 39209

WATER WELL DRILLERS LOG

TATE
G
2078

4/16 1980 Robert Yester Wall Tate
 date well completed firm name county well located

LANDOWNER: Thomas D. George
Rt. 2 Box 166A
Coldwater, Mo. 38618
 (mailing address)

description of formations encountered	from	to
Top Soil	0	2
Red Sand & Gravel	2	30
White Clay	30	60
White sand	60	70
	70	150

WELL LOCATION:
 sec. 2 T. 5 N. R. 7 E.
3 miles West of Doakville
 (distance) (direction) (nearest town)

WELL PURPOSE: home
 (home, irrigation, municipal, industrial)

WELL COMPLETION DATA:

- (1) diameter (inches) 4"
- (2) total depth (feet) 150'
- (3) static water level (feet) 130' below above top of ground.
- (4) casing PVC, 140'
 (material) (depth)
4" if telescope see back.
 (size)
- (5) screen 10', 140'
 (length) (depth to top)
4" (size) PVC (material)
- (6) pump 1/2, 10
 (HP) (yield gpm)
Elec
 (type power)
- (7) electric log No
 (yes or no)
 (organization running log)
- (8) how well bottom plugged Cap


RECEIVED
 APR 28 1980

Department of Natural Resources
 Bureau of Land & Water

DRILLERS REMARKS:

If well telescopes please sketch and show depths.

GROUND LEVEL

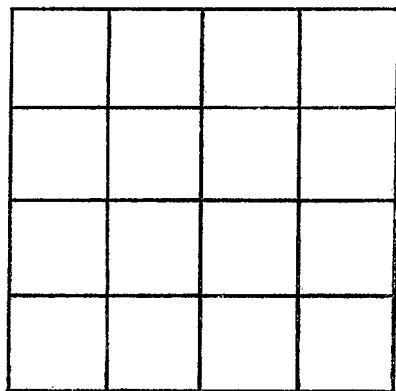

SECTION _____

Please indicate well location X.

ADDITIONAL INFORMATION

If more than one screen, show locations of each on sketch.