

MISSISSIPPI DEPARTMENT OF NATURAL RESOURCES

Bureau of Land and Water Resources

Southport Mall

P.O. Box 10631

Jackson, Mississippi 39209

WATER WELL DRILLERS LOG

DATE
G
209

4-25-86 date well completed 86 Burnett Water Well date firm name county well located

LANDOWNER: Wilma Wells
Rt 2 Box 577
Coldwater, Mo 38618
 (mailing address)

description of formations encountered	from	to
Top soil	0'	2'
Red clay sand	2'	20'
Gravel Red sand	20'	50'
White Sand clay	50'	110'
White sand	110'	130'

WELL LOCATION:
 sec. 6 T. 5 N. R. 7 E.
2 miles SE of Coldwater
 (distance) (direction) (nearest town)

WELL PURPOSE: home
 (home, irrigation, municipal, industrial)

- WELL COMPLETION DATA:
- (1) diameter (inches) 4"
 - (2) total depth (feet) 130
 - (3) static water level (feet) 70 ^{below}/_{above} top of ground.
 - (4) casing PVC 120'
 (material) (depth)
4" if telescope see back.
 (size)
 - (5) screen 10' 120'
 (length) (depth to top)
4" PVC
 (size) (material)
 - (6) pump 3/4 10
 (HP) (yield gpm)
Elec
 (type power)
 - (7) electric log No
 (yes or no)
 - (8) how well bottom plugged Cap
 (organization running log)


RECEIVED
 AUG 11 1986

Department of Natural Resources
 Bureau of Land & Water Resources

DRILLERS REMARKS:

If well telescopes please sketch and show depths.

GROUND LEVEL

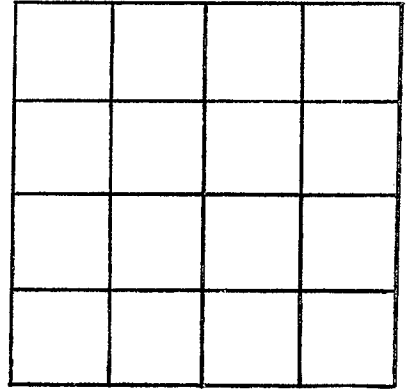

SECTION _____

Please indicate well location X.

ADDITIONAL INFORMATION

If more than one screen,
show locations of each on sketch.