

# MISSISSIPPI DEPARTMENT OF NATURAL RESOURCES

Bureau of Land and Water Resources

P.O. Box 10631

Jackson, Mississippi 39209

WATER WELL DRILLERS LOG

COUNTY WELL LOCATED <b>Jate</b>	
WELL NUMBER <b>G</b>	CODED
DATE WELL COMPLETED <b>2088</b> <b>11-8-87</b>	

PERMIT NUMBER
NAME OF DRILLING FIRM <b>HICKS WELL COMPANY</b>
<b>RT. 1 - BOX 157</b>

NAME & MAILING ADDRESS OF LANDOWNER <b>Senatobia, Miss</b> <b>Tracey Pickins</b> <b>Rt # 1</b> <b>Senatobia, MS 38608</b>		
WELL LOCATION: SEC	TOWNSHIP	RANGE
<b>25</b>	<b>5 N</b>	<b>7 E</b>
DISTANCE	DIRECTION	NEAREST TOWN
<b>3</b> Miles	<b>East</b>	<b>New Town</b>
OTHER LANDMARK		
WELL PURPOSE: <input checked="" type="checkbox"/> Home <input type="checkbox"/> Irrigation, Municipal, Industrial, Fish Pond, etc.		

PUMP DATA		
PUMP TYPE (Circle One): <input checked="" type="radio"/> Submersible <input type="radio"/> Turbine <input type="radio"/> Jet <input type="radio"/> Flowing Well, Other (Describe) _____		
POWER TYPE (Circle One): <input checked="" type="radio"/> Electric <input type="radio"/> Tractor, Diesel, Gasoline, Butane, Other (Describe) _____		
Pump Capacity (GPM) <b>18</b>	No. of Stages <b>7</b>	Setting Depth <b>80</b> FT.
PUMP TEST		
Well yielded _____ GPM with a drawdown of _____ ft. after _____ hours of pumping		

WELL DATA		
Well Depth <b>120'</b>	Casing Diameter (In.) <b>4"</b>	Casing Length (Ft.) <b>10'</b>
Type of Casing <b>Pvc</b>	Hole Depth <b>120'</b>	Depth to Static Water Level <b>60'</b>
TYPE OF COMPLETION: (Circle One or More): Gravel Packed, Underreamed, Telescoped, Natural Development, Open Hole, Other (Describe) <b>Pvc cap</b>		
Top of Lap Pipe or Reduction in Casing  FEET <input type="checkbox"/> IF TELESCOPED OR MORE THAN ONE SCREEN: USE BACK PAGE		

LOG DATA	
TYPE OF LOG RUN (Circle One): <input type="radio"/> No Log Run, Electric, Gamma Ray, Density, Sonic, Neutron, Other (Describe) _____	
Name of Organization Running Log	

SCREEN DATA		
Diameter - Inches <b>4"</b>	Length - Feet <b>10'</b>	Slot Size - Inches <b>0/3</b>
Screen Type <b>Pvc</b>	Depth to Bottom - Feet <b>120'</b>	


GEOLOGIC DATA (Office Use Only)			
Surface Elev.	Geologic Unit	Unit Thickness	Depth to Top
Subs. SWL	Date	Analysis	Aquifer Test

Driller's Remarks  <div style="text-align: center; font-size: 2em; font-weight: bold; opacity: 0.5;">RECEIVED</div> <div style="text-align: center; font-size: 1.5em; font-weight: bold;">DEC 21 1987</div>
--

DESCRIPTION OF FORMATIONS ENCOUNTERED	FROM	TO	FORMATIONS (Continued)	FROM	TO
Red Clay	0	10	<b>Department of Natural Resources</b> <b>Bureau of Land &amp; Water Resource</b>		
Red Sand	10	30			
Gravel	30	40			
White Sand	40	120			
IF MORE SPACE IS NEEDED, USE BACK					

If well telescopes please sketch and show depths.

GROUND LEVEL

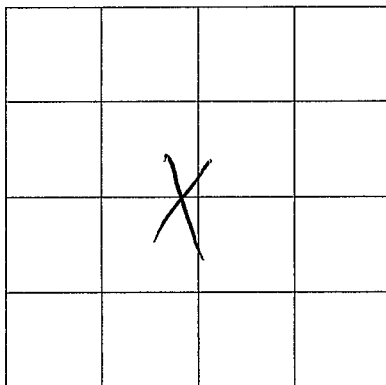

SECTION 25

Please indicate well location X.

ADDITIONAL INFORMATION

If more than one screen,  
show location of each on sketch.