

# MISSISSIPPI DEPARTMENT OF NATURAL RESOURCES

Bureau of Land and Water Resources

P.O. Box 10631

Jackson, Mississippi 39209

WATER WELL DRILLERS LOG

COUNTY WELL LOCATED <b>JATE</b>	
WELL NUMBER <b>CT</b>	CODED
<b>2099</b>	
DATE WELL COMPLETED <b>10-12-89</b>	

PERMIT NUMBER <b>HICKS WELL CO.</b>
NAME OF DRILLING FIRM <b>RT 1 BOX 157 SENATOBIA, MS 38668</b>

NAME & MAILING ADDRESS OF LANDOWNER <b>Della Harris</b>			
<b>RT 2</b>			
<b>Coldwater, MS</b>			
WELL LOCATION: SEC	TOWNSHIP	RANGE	
<u>1</u>	<u>5</u>	<u>N</u>	<u>7</u>
DISTANCE		DIRECTION	NEAREST TOWN
<u>4</u> Miles		<u>E</u>	of <u>Coldwater</u>
OTHER LANDMARK			
WELL PURPOSE: Home, Irrigation, Municipal, Industrial, Fish Pond, etc. <b>Home</b>			

PUMP DATA			
PUMP TYPE (Circle One): <u>Submersible</u> Turbine, Jet Flowing Well, Other (Describe) _____			
POWER TYPE (Circle One): <u>Electric</u> Tractor, Diesel, Gasoline, Butane, Other (Describe) _____ H/P <u>1/2</u>			
Pump Capacity (GPM)	No. of Stages	Setting Depth	
<u>10</u>	<u>9BC</u>	<u>130</u> FT.	
PUMP TEST			
Well yielded <u>10</u> GPM with a drawdown of _____ ft. after _____ hours of pumping			

WELL DATA		
Well Depth <u>160</u>	Casing Diameter (In.) <u>4"</u>	Casing Length (Ft.) <u>150</u>
Type of Casing <u>PVC</u>	Hole Depth <u>160</u>	Depth to Static Water Level <u>100</u>
TYPE OF COMPLETION: (Circle One or More): <u>Gravel Packed</u> Underreamed, Telescoped, Natural Development, Open Hole, Other		
Top of Lap Pipe or Reduction in Casing  FEET <input type="checkbox"/> IF TELESCOPED OR MORE THAN ONE SCREEN: USE BACK PAGE		

LOG DATA	
TYPE OF LOG RUN (Circle One): No Log Run, Electric, Gamma Ray, Density, Sonic, Neutron, Other (Describe) _____	
Name of Organization Running Log	

SCREEN DATA		
Diameter - Inches <u>4"</u>	Length - Feet <u>10</u>	Slot Size - Inches <u>013</u>
Screen Type <u>PVC</u>	Depth to Bottom - Feet <u>10</u>	


GEOLOGIC DATA (Office Use Only)			
Surface Elev.	Geologic Unit	Unit Thickness	Depth to Top
Subs. SWL	Date	Analysis	Aquifer Test
Driller's Remarks			

DESCRIPTION OF FORMATIONS ENCOUNTERED	FROM	TO	FORMATIONS (Continued)	FROM	TO
<b>RC</b>	<b>0</b>	<b>10</b>	<b>RECEIVED</b> <b>DEC 11 1989</b>		
<b>RC &amp; S</b>	<b>10</b>	<b>30</b>			
<b>S &amp; C</b>	<b>30</b>	<b>90</b>			
<b>WS</b>	<b>90</b>	<b>160</b>			

IF MORE SPACE IS NEEDED, USE BACK

If well telescopes please  
sketch and show depths.

GROUND LEVEL

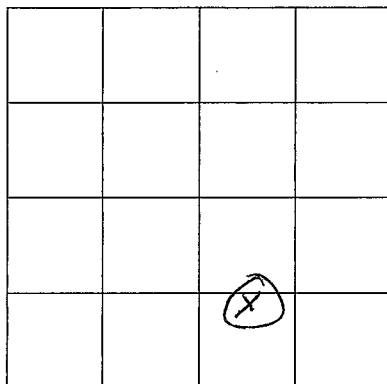

SECTION \_\_\_\_\_

Please indicate well location X.

ADDITIONAL INFORMATION

If more than one screen,  
show location of each on sketch.