

MISSISSIPPI DEPARTMENT OF ENVIRONMENTAL QUALITY

Office of Land and Water Resources

P. O. Box 10631
Jackson, MS 39289-0631
WATER WELL DRILLERS LOG

COUNTY WELL LOCATED	
TATE	
WELL NUMBER	CODED
G 2119	
DATE WELL COMPLETED	
9-27-95	

PERMIT NUMBER	HICKS WELL CO.
NAME OF DRILLING FIRM	RT. 1 BOX 157
	SENATOBIA, MS 38668

NAME & MAILING ADDRESS OF LANDOWNER		
Alan Price		
Hag Linda Dr.		
Senatobia, MS		
WELL LOCATION:	SEC TOWNSHIP RANGE	
	8 5 N 7 E	
DISTANCE	DIRECTION	NEAREST TOWN
3 Miles	S/E	Coldwater
OTHER LANDMARK		
WELL PURPOSE: Home, Irrigation, Municipal, Industrial, Fish Pond, etc.		
Home		

PUMP DATA		
PUMP TYPE (Circle One):		
<input checked="" type="checkbox"/> Submersible, Turbine, Jet, Flowing Well, Other (Describe)		
POWER TYPE (Circle One):		
<input checked="" type="checkbox"/> Electric, Tractor, Diesel, Gasoline, Butane, Other (Describe) H/P 1		
Pump Capacity (GPM)	No. of Stages	Setting Depth
18	12	160 FT.
PUMP TEST		
Well yielded _____ GPM with a drawdown of _____ ft. after _____ hours of pumping.		

WELL DATA		
Well Depth	Casing Diameter (In.)	Casing Length (Ft.)
190'	4"	180'
Type of Casing	Hole Depth	Depth to Static Water Level
PVC	190'	120'

LOG DATA	
TYPE OF LOG RUN (Circle One):	
<input type="checkbox"/> No Log Run, Electric, Gamma Ray, Density, Sonic, Neutron, Other (Describe)	
Name of Organization Running Log	

TYPE OF COMPLETION: (Circle One or More):	
<input checked="" type="checkbox"/> Gravel Packed, Underreamed, Telescoped, Natural Development, Open Hole, Other (Describe)	


GEOLOGIC DATA (Office Use Only)			
Surface Elev.	Geologic Unit	Unit Thickness	Depth to Top
Subs. SWL	Date	Analysis	Aquifer Test

WELL GROUTED TO A DEPTH OF 10' FEET
Type Grout (circle one): Cement, Bentonite, or Mix

Driller's Remarks	
Top of Lap Pipe or Reduction in Casing	
FEET	IF TELESCOPED OR MORE THAN ONE SCREEN: USE BACK PAGE


SCREEN DATA		
Diameter - Inches	Length - Feet	Slot Size - Inches
4"	10'	013
Screen Type	Depth to Bottom - Feet	
PVC	10'	

DESCRIPTION OF FORMATIONS ENCOUNTERED	FROM	TO
SAND & CLAY	0	80
CLAY	80	160
WHITE SAND	160	190

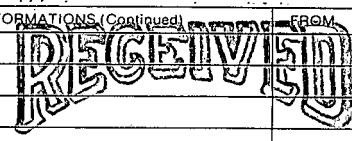FORMATIONS (Continued)		FROM	TO
			
JAN 16 1996			
Dept. of Environmental Quality Office of Land & Water Resources			
IF MORE SPACE IS NEEDED, USE BACK			

If well telescopes please
sketch and show depths.

GROUND LEVEL

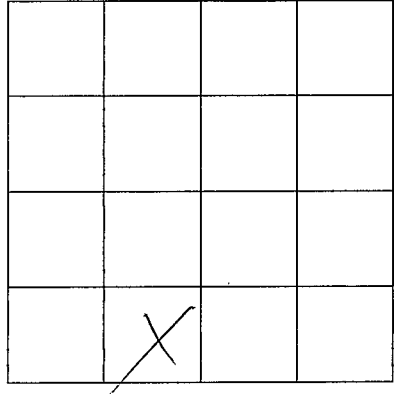

SECTION 8

Please indicate well location X.

ADDITIONAL INFORMATION

If more than one screen,
show location of each on sketch.