

MISSISSIPPI DEPARTMENT OF ENVIRONMENTAL QUALITY

Office of Land and Water Resources

P. O. Box 10631

Jackson, MS 39289-0631

WATER WELL DRILLERS LOG

COUNTY WELL LOCATED  
TALE

WELL NUMBER  
G 2120

CODED

DATE WELL COMPLETED  
5-19-95

PERMIT NUMBER  
**HICKS WELL CO.**

NAME OF DRILLING FIRM  
RT. 1 BOX 157  
**SENATOBIA, MS 38668**

NAME & MAILING ADDRESS OF LANDOWNER  
PAT HARDISON

206 Hunter Dr

Senatobia, MS.

WELL LOCATION: SEC 26 TOWNSHIP 5 N RANGE 7 E

DISTANCE 2 Miles DIRECTION E of NEAREST TOWN Senatobia

OTHER LANDMARK

WELL PURPOSE:  Home Irrigation, Municipal, Industrial, Fish Pond, etc.  
Home

PUMP DATA

PUMP TYPE (Circle One):  
 Submersible Turbine, Jet, Flowing Well,  
Other (Describe)

POWER TYPE (Circle One):  
 Electric, Tractor, Diesel, Gasoline, Butane,  
Other (Describe) H/P 1/2

Pump Capacity (GPM) 10 No. of Stages 9 Setting Depth 140 FT.

PUMP TEST

Well yielded \_\_\_\_\_ GPM with  
a drawdown of \_\_\_\_\_ ft.  
after \_\_\_\_\_ hours of pumping

WELL DATA

Well Depth 160' Casing Diameter (In.) 4" Casing Length (Ft.) 150

Type of Casing PVC Hole Depth 160' Depth to Static Water Level 100'

TYPE OF COMPLETION: (Circle One or More):  
 Gravel Packed, Underreamed, Telescoped,  
Natural Development, Open Hole, Other

LOG DATA

TYPE OF LOG RUN (Circle One): No Log Run, Electric, Gamma Ray, Density, Sonic, Neutron, Other (Describe)

Name of Organization Running Log

WELL GROUTED TO A DEPTH OF 10 FEET  
Type Grout (circle one):  Cement, Bentonite, or Mix

GEOLOGIC DATA (Office Use Only)

Surface Elev.	Geologic Unit	Unit Thickness	Depth to Top
Subs. SWL	Date	Analysis	Aquifer Test

Driller's Remarks

Top of Lap Pipe or Reduction in Casing

FEET IF TELESCOPED OR MORE THAN ONE SCREEN: USE BACK PAGE

SCREEN DATA

Diameter - Inches 4" Length - Feet 10' Slot Size - Inches .013

Screen Type PVC Depth to Bottom - Feet 10'

DESCRIPTION OF FORMATIONS ENCOUNTERED	FROM	TO
<u>Red Sand</u>	<u>0</u>	<u>40</u>
<u>Sand &amp; Clay</u>	<u>40</u>	<u>120</u>
<u>White Sand</u>	<u>120</u>	<u>160</u>

FORMATIONS (Continued)

FROM	TO

**RECEIVED**


**JAN 16 1996**

Dept. of Environmental Quality  
Office of Land & Water Resources

IF MORE SPACE IS NEEDED, USE BACK

If well telescopes please  
sketch and show depths.

GROUND LEVEL

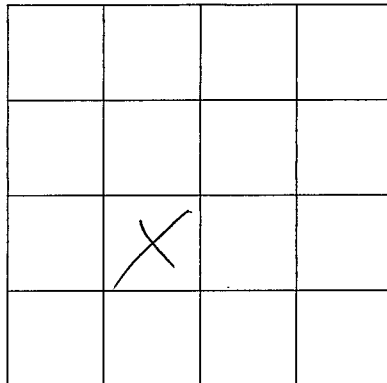

SECTION 26

Please indicate well location X.

ADDITIONAL INFORMATION

If more than one screen,  
show location of each on sketch.