

MISSISSIPPI DEPARTMENT OF ENVIRONMENTAL QUALITY

Office of Land and Water Resources

P. O. Box 10631
Jackson, MS 39289-0631
WATER WELL DRILLERS LOG

COUNTY WELL LOCATED TATE	
WELL NUMBER G	CODED 2122
DATE WELL COMPLETED 2/20/97	

PERMIT NUMBER HICK WATER WELL 00
ADDRESS 30242 HWY. 4 EAST
CITY SENATOBIA, MS 38668

NAME & MAILING ADDRESS OF LANDOWNER Johnny Or Josephine Moore			
102 Rifle Range Rd.			
Coldwater, MS 38618			
WELL LOCATION: SEC	TOWNSHIP	RANGE	
8	S	N	7
DISTANCE		DIRECTION	NEAREST TOWN
1	Miles	S	Coldwater
OTHER LANDMARK			
WELL PURPOSE <u>Home</u> , Irrigation, Municipal, Industrial, Fish Pond, etc.			

PUMP DATA			
PUMP TYPE (Circle One): <u>Submersible</u> , Turbine, Jet, Flowing Well, Other (Describe) _____			
POWER TYPE (Circle One): <u>Electric</u> , Tractor, Diesel, Gasoline, <u>1/2</u> Butane, Other (Describe) _____ H/P _____			
Pump Capacity (GPM) 10	No. of Stages	Setting Depth 123 FT.	
PUMP TEST			
Well yielded _____ GPM with a drawdown of <u>no Test</u> ft. after _____ hours of pumping			

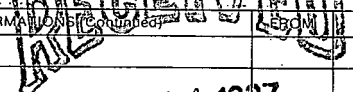
WELL DATA		
Well Depth 124	Casing Diameter (In.) 4	Casing Length (Ft.) 114
Type of Casing PVC	Hole Depth 124	Depth to Static Water Level 80
TYPE OF COMPLETION: (Circle One or More): <u>Gravel Packed</u> , Underreamed, Telescoped, Natural Development, Open Hole, Other (Describe) _____		
WELL GROUTED TO A DEPTH OF 3 FEET Type Grout (circle one): <u>Cement</u> , Bentonite, or Mix		

LOG DATA	
TYPE OF LOG RUN (Circle One): Electric, Gamma Ray, Density, <u>No Log Run</u> , Other (Describe) _____	
Name of Organization Running Log	

SCREEN DATA		
Diameter - Inches 4	Length - Feet 10	Slot Size - Inches .013
Screen Type PVC Slot	Depth to Bottom - Feet 114	

GEOLOGIC DATA (Office Use Only)			
Surface Elev.	Geologic Unit	Unit Thickness	Depth to Top
Subs. SWL	Date	Analysis	Aquifer Test
Driller's Remarks			
Top of Lap Pipe or Reduction in Casing			

DESCRIPTION OF FORMATIONS ENCOUNTERED	FROM	TO
Red Clay	0	10
Red Sand	10	40
White Sand	40	124

FORM NO. _____ (Continued)	TO
	
APR 11 1997	
Dept. of Environmental Quality Office of Land & Water Resources	
IF MORE SPACE IS NEEDED, USE BACK	

If well telescopes please
sketch and show depths.

GROUND LEVEL

X			

SECTION 8

Please indicate well location X.

ADDITIONAL INFORMATION

If more than one screen,
show location of each on sketch.