

**MISSISSIPPI DEPARTMENT OF ENVIRONMENTAL QUALITY**

Office of Land and Water Resources

P. O. Box 10631  
Jackson, MS 39289-0631  
WATER WELL DRILLERS LOG

COUNTY WELL LOCATED <b>TATE</b>	
WELL NUMBER <b>G 2131</b>	CODED
DATE WELL COMPLETED <b>10-12-98</b>	

PERMIT NUMBER
NAME OF DRILLING FIRM <b>HICK WATER WELL CO.</b>
<b>30242 HWY. 4 EAST</b>
<b>SENATOBIA, MS 38668</b>

NAME & MAILING ADDRESS OF LANDOWNER <b>JAMES MAPLES</b> <b>P.O. Box 361</b> <b>Senatobia, MS 38668</b>			
WELL LOCATION: SEC	TOWNSHIP	RANGE	
<b>26</b>	<b>5</b>	<b>N 7</b>	<b>W</b>
DISTANCE	DIRECTION	NEAREST TOWN	
<b>1/2</b> Miles	<b>E</b>	<b>Newtown</b>	
OTHER LANDMARK <b>@ 17123 Hwy 4E</b>			
WELL PURPOSE (Home, Irrigation, Municipal, Industrial, Fish Pond, etc.)			

PUMP DATA		
PUMP TYPE (Circle One): <u>Submersible</u> Turbine, Jet, Flowing Well, Other (Describe) _____		
POWER TYPE (Circle One): <u>Electric</u> Tractor, Diesel, Gasoline, Butane, Other (Describe) _____ H/P <u>1/2</u>		
Pump Capacity (GPM) <b>10</b>	No. of Stages	Setting Depth <b>_____</b> FT.
PUMP TEST		
Well yielded _____ GPM with a drawdown of <u>no Test</u> ft. after _____ hours of pumping		

WELL DATA		
Well Depth <b>160</b>	Casing Diameter (In.) <b>4</b>	Casing Length (Ft.) <b>150</b>
Type of Casing <b>PVC</b>	Hole Depth <b>160</b>	Depth to Static Water Level <b>70</b>
TYPE OF COMPLETION: (Circle One or More): <u>Gravel Packed</u> , Underreamed, Telescoped, Natural Development, Open Hole, Other (Describe) _____		
WELL GROUTED TO A DEPTH OF <u>3</u> FEET Type Grout (circle one): <u>Cement</u> , Bentonite, or Mix		

LOG DATA	
TYPE OF LOG RUN (Circle One): Electric, Gamma Ray, Density, <u>No Log Run</u> , Other (Describe) _____	
Name of Organization Running Log	

SCREEN DATA		
Diameter - Inches <b>4</b>	Length - Feet <b>10</b>	Slot Size - Inches <b>.014</b>
Screen Type <b>PVC slot</b>	Depth to Bottom - Feet <b>150</b>	


GEOLOGIC DATA (Office Use Only)			
Surface Elev.	Geologic Unit	Unit Thickness	Depth to Top
Subs. SWL	Date	Analysis	Aquifer Test
Driller's Remarks			
Top of Lap Pipe or Reduction in Casing			
FEET		IF TELESCOPED OR MORE THAN ONE SCREEN: USE BACK PAGE	

DESCRIPTION OF FORMATIONS ENCOUNTERED	FROM	TO
<b>Red + White Clay</b>	<b>0</b>	<b>15</b>
<b>Red + White Clay + Sand</b>	<b>15</b>	<b>70</b>
<b>White Sand + Clay</b>	<b>70</b>	<b>125</b>
<b>White Sand</b>	<b>125</b>	<b>160</b>

FORMATIONS (Continued)	FROM	TO
<b>RECEIVED</b>		
<b>DEC 28 1998</b>		
<b>Dept. of Environmental Quality</b> <b>Office of Land &amp; Water Resources</b>		
IF MORE SPACE IS NEEDED, USE BACK		

If well telescopes please sketch and show depths.

GROUND LEVEL

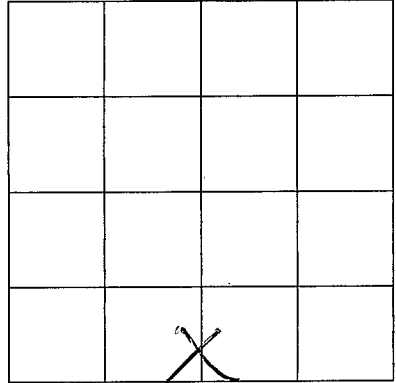

SECTION 26

Please indicate well location X.

ADDITIONAL INFORMATION

If more than one screen,  
show location of each on sketch.