

MISSISSIPPI DEPARTMENT OF NATURAL RESOURCES

Bureau of Land and Water Resources

Southport Mall

P.O. Box 10631

Jackson, Mississippi 39209

WATER WELL DRILLERS LOG

TARE
G
2075
2152

4-8-1986 date well completed *86 Pulaski Water Well State* firm name county well located

LANDOWNER: *Lowell Brown*
Caldwater, Mrs
 (mailing address)

description of formations encountered	from	to
<i>200 Soil</i>	<i>0</i>	<i>2</i>
<i>Clay</i>	<i>2</i>	<i>20</i>
<i>Clay sand</i>	<i>20</i>	<i>70</i>
<i>Yellow sand</i>	<i>70</i>	<i>145</i>

WELL LOCATION:
 sec. 2 T. 5 N. R. 7 E
3 1/2 miles SW of Pragville
 (distance) (direction) (nearest town)

WELL PURPOSE: *Home*
 (home, irrigation, municipal, industrial)

- WELL COMPLETION DATA:
- (1) diameter (inches) 4"
 - (2) total depth (feet) 145'
 - (3) static water level (feet) 60' below above top of ground.
 - (4) casing PVC, 135'
 (material) (depth)
4" if telescope see back.
 (size)
 - (5) screen 10', 135'
 (length) (depth to top)
4", PVC
 (size) (material)
 - (6) pump 1/2, 10
 (HP) (yield gpm)
Elec
 (type power)
 - (7) electric log NO
 (yes or no)
 (organization running log)
 - (8) how well bottom plugged Cap


STATE OF MISSISSIPPI
 BUREAU OF LAND & WATER RESOURCES
 APR 28 1986

DRILLERS REMARKS:

Department of Natural Resources
 Bureau of Land & Water Resources

If well telescopes please sketch and show depths.

GROUND LEVEL

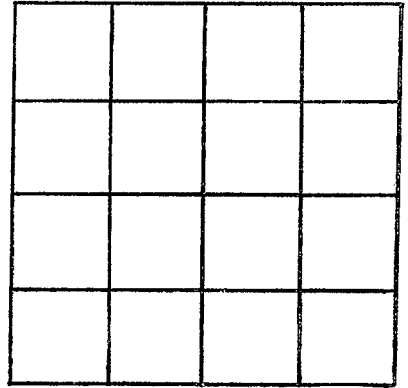

SECTION _____

Please indicate well location X.

ADDITIONAL INFORMATION

If more than one screen, show locations of each on sketch.