

MISSISSIPPI DEPARTMENT OF NATURAL RESOURCES

Bureau of Land and Water Resources

COUNTY WELL LOCATED TATE	
WELL NUMBER H	CODED
DATE WELL COMPLETED 5-30-89	

PERMIT NUMBER
NAME OF DRILLING FIRM Hicks Well Co

P.O. Box 10631
Jackson, Mississippi 39209
WATER WELL DRILLERS LOG

NAME & MAILING ADDRESS OF LANDOWNER Jimmy McCarver		
RT-1 Senatobia, MS.		
38668		
WELL LOCATION: SEC <u> </u> TOWNSHIP <u> </u> RANGE <u> </u>		
<u> </u> <u> </u> <u> </u> <u> </u> <u> </u> <u> </u>		
DISTANCE <u> </u> DIRECTION <u> </u> NEAREST TOWN <u> </u>		
<u>4</u> Miles <u>EAST</u> of <u>Senatobia</u>		
OTHER LANDMARK Cross-Senatobia Lakes		
WELL PURPOSE: Home, Irrigation, Municipal, Industrial, Fish Pond, etc. Home		

PUMP DATA			
PUMP TYPE (Circle One): <u>Submersible</u> Turbine, Jet, Flowing Well, Other (Describe) _____			
POWER TYPE (Circle One): <u>Electric</u> Tractor, Diesel, Gasoline, Butane, Other (Describe) _____			
Pump Capacity (GPM)	No. of Stages	Setting Depth	
10	9	120 FT.	
PUMP TEST Well yielded _____ GPM with a drawdown of _____ ft. after _____ hours of pumping			

WELL DATA			
Well Depth 140	Casing Diameter (In.) 4"	Casing Length (Ft.) 130	
Type of Casing PVC	Hole Depth 140	Depth to Static Water Level 100	
TYPE OF COMPLETION: (Circle One or More): <u>Gravel Packed</u> , Underreamed, Telescoped, Natural Development, Open Hole, Other _____ (Describe) _____			
Top of Lap Pipe or Reduction in Casing			
FEET		IF TELESCOPED OR MORE THAN ONE SCREEN: USE BACK PAGE	

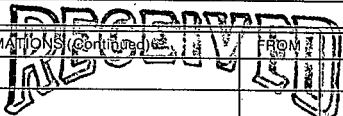
LOG DATA	
TYPE OF LOG RUN (Circle One): <u>Electric</u> Gamma Ray, Density, Sonic, Neutron, Other (Describe) _____	
No Log Run, _____	
Name of Organization Running Log	

SCREEN DATA		
Diameter - Inches 4"	Length - Feet 10'	Slot Size - Inches 013
Screen Type PVC		Depth to Bottom - Feet 140

GEOLOGIC DATA (Office Use Only)			
Surface Elev.	Geologic Unit	Unit Thickness	Depth to Top
Subs. SWL	Date	Analysis	Aquifer Test

Driller's Remarks

DESCRIPTION OF FORMATIONS ENCOUNTERED	FROM	TO	FORMATION(S) (Continued) FROM TO
Red clay	0	20	
SAND-clay gravel	20	60	
SAND-clay	60	100	
W-S'	100	140	

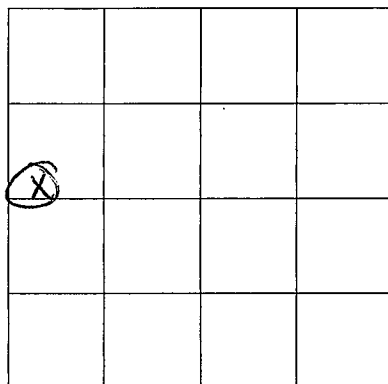

JUN 8 1989

Department of Natural Resources
Bureau of Land & Water Resources

IF MORE SPACE IS NEEDED, USE BACK

If well telescopes please
sketch and show depths.

GROUND LEVEL



SECTION _____

Please indicate well location X.

ADDITIONAL INFORMATION

If more than one screen,
show location of each on sketch.