

Date
 H1
 2-8-68

MISSISSIPPI
 BOARD OF WATER COMMISSIONERS
 416 North State Street
 Jackson, Mississippi 39201

CODED
 BASED
 CODED

WATER WELL DRILLERS LOG

2-8 1968 Harris Bros. Tate
 date well completed firm name county well located

LANDOWNER: Charles R. Blair
 Rte 2
 Coldwater Miss.
 (mailing address)

description of formations encountered	depth	
	from	to
top soil	0	15
red sand	15	40
clay & sand mixed	40	80
fine sand	80	100
coarse sand	100	110

WELL LOCATION:
 sec. 10 T. 5 N. R. 6 E
 1 1/2 miles South of Independence
 (distance) (direction) (nearest town)

WELL PURPOSE: home
 (home, irrigation, municipal, industrial)

- WELL COMPLETION DATA:
- (1) diameter (inches) 4"
 - (2) total depth (feet) 110'
 - (3) static water level (feet) 60' below top of ground.
 - (4) casing Plastic 103' (material) (depth)
 4" (size) if telescope see back.
 - (5) screen 7' 103' (length) (depth to top)
 #008 Plastic (size) (material)
 - (6) pump 3/4 HP 7 (yield gpm)
 elec. (type power)
 - (7) electric log no (yes or no)
 - (organization running log)
 - (8) how well bottom plugged back shot

CODED
 CODED

CODED


DEC 23 1968

MISS. BD. OF
 WATER CONTROL

DRILLERS REMARKS:

If well telescopes please sketch and show depths.

GROUND LEVEL

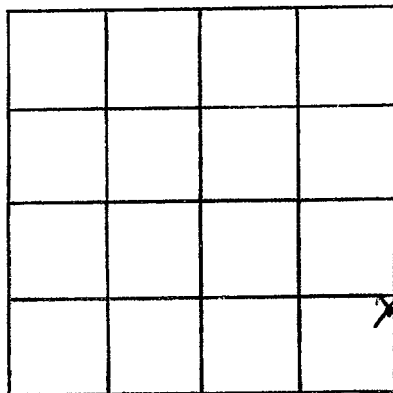

SECTION 10

Please indicate well location X.

ADDITIONAL INFORMATION

If more than one screen,
show locations of each on sketch.