

Zato
H 3
2-20-68

MISSISSIPPI
 BOARD OF WATER COMMISSIONERS
 416 North State Street
 Jackson, Mississippi 39201



WATER WELL DRILLERS LOG

2-20 1968 Harris Bros Zato
 date well completed firm name county well located

LANDOWNER: Mitchell May
pto. 2
Coldwater
 (mailing address)

Description of formations encountered	from	to
<u>top soil</u>	<u>0</u>	<u>15</u>
<u>red sand</u>	<u>15</u>	<u>45</u>
<u>clay & sand</u>	<u>45</u>	<u>80</u>
<u>coarse sand</u>	<u>80</u>	<u>100</u>

WELL LOCATION:
 sec 2 T S N R 6 E
1 1/2 miles South of Independence
 (distance) (direction) (nearest town)

WELL PURPOSE: home
 (home, irrigation, municipal, industrial)

WELL COMPLETION DATA:
 (1) diameter (inches) 4^{1/2}
 (2) total depth (feet) 100
 (3) static water level (feet) 60 below above top of ground.
 (4) casing Plastic, 93
 (material) (depth)
4⁰¹ if telescope see back.
 (size)
 (5) screen 7, 43
 (length) (depth to top)
008, Plastic
 (size) (material)
 (6) pump 7/4, 7
 (HP) (yield gpm)
elec.
 (type power)
 (7) electric log no
 (yes or no)

CODED

(organization running log)
 (8) how well bottom plugged luck
short


DRILLERS REMARKS:

11-5 23 1968



If well telescopes please sketch and show depths.

GROUND LEVEL

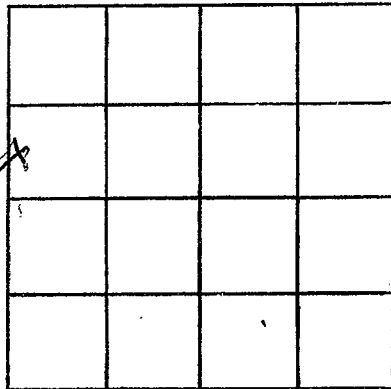

A			

SECTION 2

Please indicate well location X.

ADDITIONAL INFORMATION

If more than one screen,
show locations of each on sketch.