

Late  
H4  
4-8-68

MISSISSIPPI  
BOARD OF WATER COMMISSIONERS  
416 North State Street  
Jackson, Mississippi 39201

CODED

WATER WELL DRILLERS LOG

4-8 1968 Harris Bros Late  
date well completed firm name county well located

LANDOWNER: Jessie May

description of formations encountered

from to

pto 2.

Coldwater

(mailing address)

top soil	0	15
clay & h. sand	15	45
W. clay & sand	45	120
Coarse w. sand	120	130

WELL LOCATION:

sec. 11 T-S R-6  
1 1/2 miles S of Independence  
(distance) (direction) (nearest town)

WELL PURPOSE: none  
(home, irrigation, municipal, industrial)

WELL COMPLETION DATA:

- diameter (inches) 4 1/2
- total depth (feet) 130
- static water level (feet) 80  below  above top of ground.
- casing Plastic, 123  
(material) (depth)  
4 1/2 if telescope see back.  
(size)
- screen 17', 123  
(length) (depth to top)  
008, Plastic  
(size) (material)
- pump 3/4, 7  
(HP) (yield gpm)  
elec.  
(type power)
- electric log no  
(yes or no)

(organization running log)

(8) how well bottom plugged back  
and

DRILLERS REMARKS:


CODED

MAR 7 1968

MISS. BD. OF  
WATER COMMISSIONERS

If well telescopes please sketch and show depths.

GROUND LEVEL

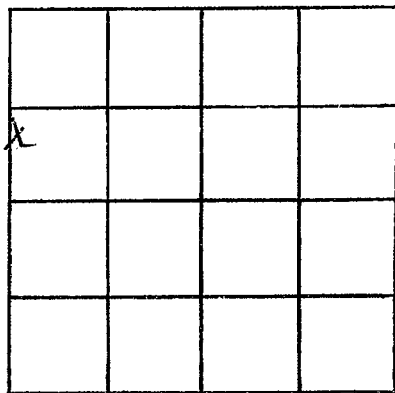

SECTION 11

Please indicate well location X.

ADDITIONAL INFORMATION

If more than one screen,  
show locations of each on sketch.