

Late  
H5  
6-20-68

MISSISSIPPI  
BOARD OF WATER COMMISSIONERS  
416 North State Street  
Jackson, Mississippi 39201

CODED

WATER WELL DRILLERS LOG

6-20 1968 Harris Bros Late  
date well completed firm name county well located

LANDOWNER: Aubrey Henderson  
P.O. 2 Box 264  
Caldwater  
(mailing address)

description of formations encountered	from	to
top soil	0	15
clay & sand	15	45
clay	45	75
clay sand	75	95
W. sand	95	107

WELL LOCATION:  
sec. 5 T 5 N R 6 E  
1 miles S of Poyyville  
(distance) (direction) (nearest town)

WELL PURPOSE: none  
(home, irrigation, municipal, industrial)

- WELL COMPLETION DATA:
- (1) diameter (inches) 4
  - (2) total depth (feet) 107
  - (3) static water level (feet) 80 <sup>below</sup> <sub>above</sub> top of ground.
  - (4) casing Plastic 100 (material) (depth)  
4' (size) if telescope see back.
  - (5) screen 7' 100 (length) (depth to top)  
008 Plastic (size) (material)
  - (6) pump 3/4 7 (HP) (yield gpm)  
elec (type power)
  - (7) electric log no (yes or no)  
(organization running log)
  - (8) how well bottom plugged druck  
shot

CODED


MAR 7 1969

MISS. BD. OF  
WATER COMM.

DRILLERS REMARKS:

If well telescopes please sketch and show depths.

GROUND LEVEL

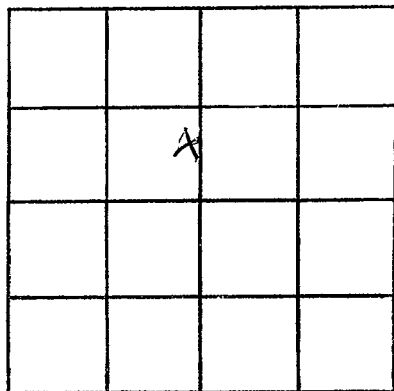

SECTION 5

Please indicate well location X.

ADDITIONAL INFORMATION

If more than one screen,  
show locations of each on sketch.