

Tate
H 6
7-68

MISSISSIPPI
BOARD OF WATER COMMISSIONERS
416 North State Street
Jackson, Mississippi 39201

CODED

WATER WELL DRILLERS LOG

7-22 1968 Harris Bus Tate
date well completed firm name county well located

LANDOWNER: Louis
Sandy
P.O. Caldwellwater
(mailing address)

description of formations encountered	from	to
top soil	0	20
fine sand	20	45
clay sand	45	85
gray clay	85	120
clay + sand	120	140
coarse sand	140	160

WELL LOCATION:
sec. 5 T 5 N R 6 E
11 miles S.E. of Caldwellwater
(distance) (direction) (nearest town)

WELL PURPOSE: none
(home, irrigation, municipal, industrial)

WELL COMPLETION DATA:

- (1) diameter (inches) 4
- (2) total depth (feet) 160
- (3) static water level (feet) 80 ^{below} _{above} top of ground.
- (4) casing Plastic, 14" _(material) 14' _(depth)
4" _(size) if telescope see back.
- (5) screen 14' _(length) 14' _(depth to top)
008 Plastic _(size) _(material)
- (6) pump 7/4 _(HP) 7 _(yield gpm)
elec. _(type power)
- (7) electric log no _(yes or no)

(organization running log)
- (8) how well bottom plugged back
shot

CODED


MAR 10 1969

DRILLERS REMARKS:

MISS. Bd. of
WATER COMMISSIONERS

If well telescopes please sketch and show depths.

GROUND LEVEL

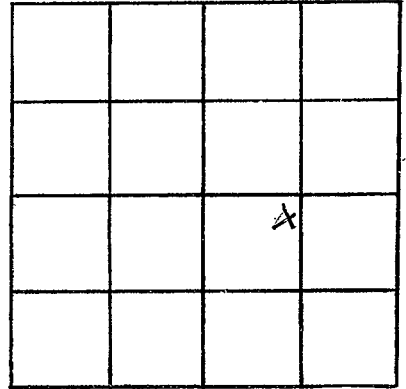

SECTION 5

Please indicate well location X.

ADDITIONAL INFORMATION

If more than one screen, show locations of each on sketch.