

Tate  
H 7  
8-68

MISSISSIPPI  
BOARD OF WATER COMMISSIONERS  
416 North State Street  
Jackson, Mississippi 39201

CODED

WATER WELL DRILLERS LOG

8-17 1968 Harris Bros. Tate  
date well completed firm name county well located

LANDOWNER: E. B. Stewart  
pto 2  
Coldwater  
(mailing address)

WELL LOCATION:  
sec. 1 T. 5 N. R. 6 E.  
3 miles S.E. of Independence  
(distance) (direction) (nearest town)

WELL PURPOSE: none  
(home, irrigation, municipal, industrial)

WELL COMPLETION DATA:

(1) diameter (inches) 4"

(2) total depth (feet) 120

(3) static water level (feet) 75 below above top of ground.

(4) casing Plastic 1 1/2" (material) (depth)  
4" if telescope see back. (size)

(5) screen 7' 1 1/2" (length) (depth to top)  
008 Plastic (size) (material)

(6) pump 3/4 HP 7 (yield gpm)  
elec (type power)

(7) electric log no (yes or no)

(organization running log)

(8) how well bottom plugged back  
shot

description of formations encountered	from	to
<u>top soil</u>	<u>0</u>	<u>15</u>
<u>fine gravel</u>	<u>15</u>	<u>30</u>
<u>clay</u>	<u>30</u>	<u>60</u>
<u>clay + sand</u>	<u>60</u>	<u>100</u>
<u>Coarse sand</u>	<u>100</u>	<u>120</u>

CODED


MAR 10 1969

MISS. BD. OF  
WATER COM. LOG

DRILLERS REMARKS:

If well telescopes please sketch and show depths.

GROUND LEVEL

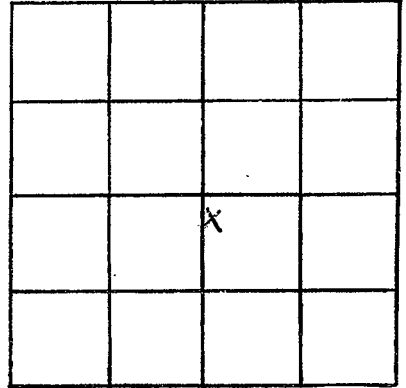

SECTION /

Please indicate well location X.

ADDITIONAL INFORMATION

If more than one screen, show locations of each on sketch.