

Zate
HB
11-19-68

MISSISSIPPI
 BOARD OF WATER COMMISSIONERS
 416 North State Street
 Jackson, Mississippi 39201

CODED

CODED

WATER WELL DRILLERS LOG

11-19-68 1968 Harris Bros Zate
 date well completed firm name county well located

LANDOWNER: W. C. Walker

description of formations encountered

from to

Rte 2
Coldwater
 (mailing address)

<u>top soil</u>	<u>0</u>	<u>20</u>
<u>gravel + sand</u>	<u>20</u>	<u>45</u>
<u>w clay</u>	<u>45</u>	<u>70</u>
<u>clay + sand</u>	<u>70</u>	<u>115</u>
<u>coarse sand</u>	<u>115</u>	<u>140</u>

WELL LOCATION:

sec. 3 T. 5 N. R. 6 E
3 1/4 miles SW of Independence
 (distance) (direction) (nearest town)

WELL PURPOSE: drain
 (home, irrigation, municipal, industrial)

WELL COMPLETION DATA:

- (1) diameter (inches) 4"
- (2) total depth (feet) 140'
- (3) static water level (feet) 80' ^{below} _{above} top of ground.
- (4) casing plastic, 126'
 (material) (depth)
4" If telescope see back.
 (size)
- (5) screen 14' 126'
 (length) (depth to top)
008, plastic
 (size) (material)
- (6) pump 1 1/2 25
 (HP) (yield gpm)
elec.
 (type power)
- (7) electric log no
 (yes or no)

(organization running log)

(8) how well bottom plugged back
cap

DRILLERS REMARKS:


CODED

MAR 13 1969

MISS. BD. OF
 WATER COMM.

If well telescopes please sketch and show depths.

GROUND LEVEL

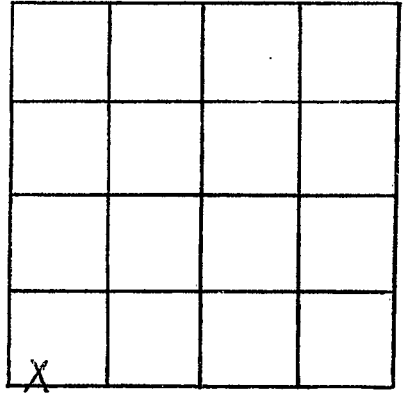

SECTION 3

Please indicate well location X.

ADDITIONAL INFORMATION

If more than one screen, show locations of each on sketch.