

Zate
H 12
1-24-69

MISSISSIPPI
 BOARD OF WATER COMMISSIONERS
 416 North State Street
 Jackson, Mississippi 39201

CODED
 CODED

WATER WELL DRILLERS LOG

1-24 1969 Harris Bros Zate
 date well completed firm name county well located

LANDOWNER: James Bolton
Rte 2
Coldwater
 (mailing address)

description of formations encountered	from	to
<u>top soil</u>	<u>0</u>	<u>20</u>
<u>red gravel</u>	<u>20</u>	<u>45</u>
<u>clay</u>	<u>45</u>	<u>80</u>
<u>Indepance fine sand</u>	<u>80</u>	<u>115</u>
<u>Coarse sand</u>	<u>115</u>	<u>127</u>

WELL LOCATION:
 sec. 9 T S N R 6 E
5 miles S.W. of Indepance
 (distance) (direction) (nearest town)

WELL PURPOSE: home
 (home, irrigation, municipal, industrial)

- WELL COMPLETION DATA:
 (1) diameter (inches) 4
 (2) total depth (feet) 127
 (3) static water level (feet) 80 below top of ground
 (4) casing Plasti 120
 (material) (depth)
4 (size) If telescope see back.
 (5) screen 7' 120
 (length) (depth to top)
see Plasti
 (size) (material)
 (6) pump 3/4 7
 (MP) (yield gpm)
ela
 (type power)
 (7) electric log no
 (yes or no)
 (organization running log)
 (8) how well bottom plugged brack
spot

CODED


MIAR 13 1969

MISS. BD. OF
 WATER COMM.

DRILLERS REMARKS:

If well telescopes please sketch and show depths.

GROUND LEVEL

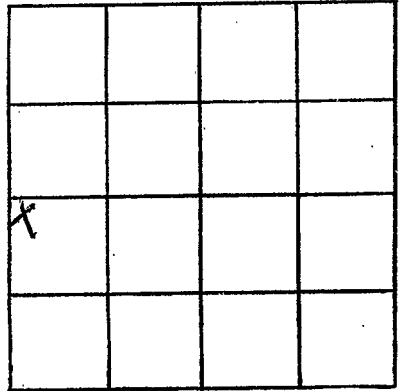

SECTION 9

Please indicate well location X.

ADDITIONAL INFORMATION

If more than one screen,
show locations of each on sketch.